

Certified *AS BUILT Drawing | Comm# 882239 | BN 2-24 | Cert drawing by: | Date: 6·3·22

verbindlich für Kommissions-Nr.:
binding for comission-no.: 882239


Copyright: This drawing is cur property and patented for us according to the law of copyright and associated rights !

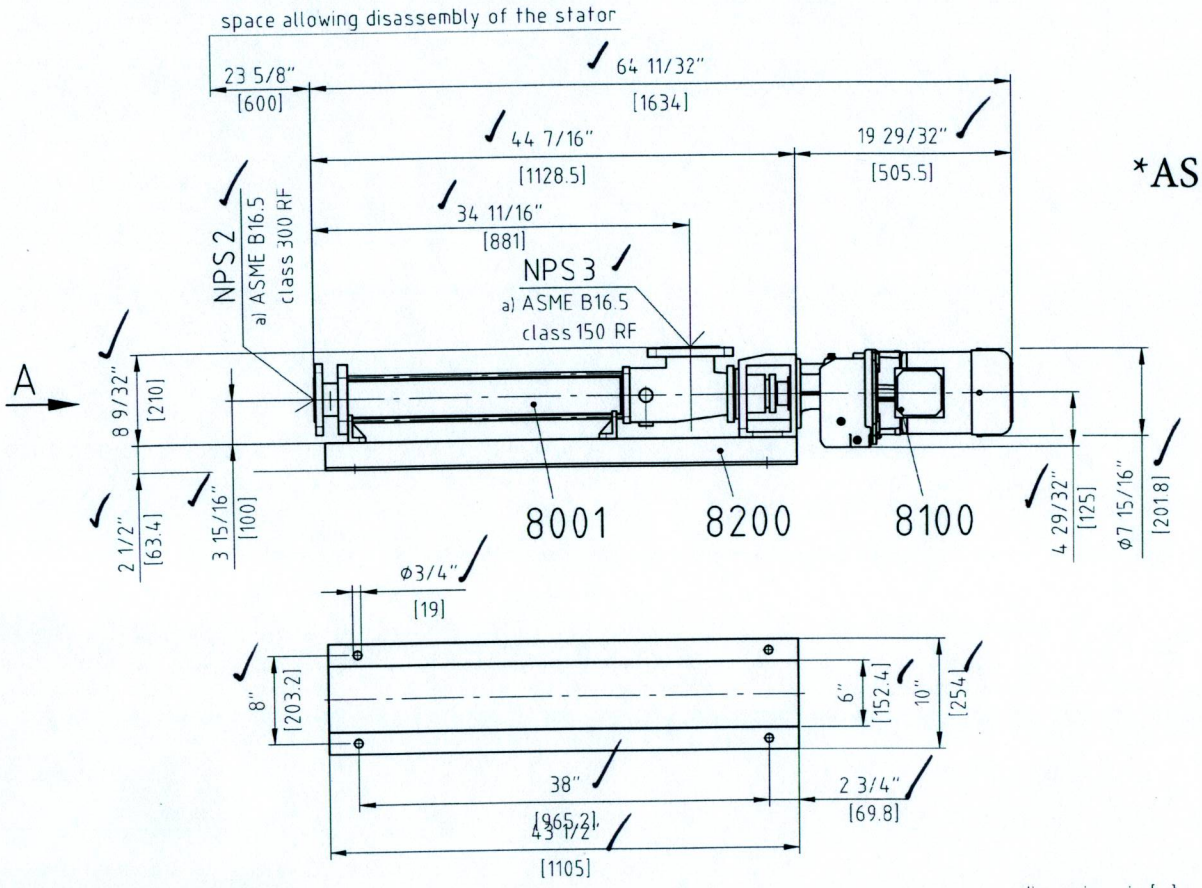

*AS BUILT

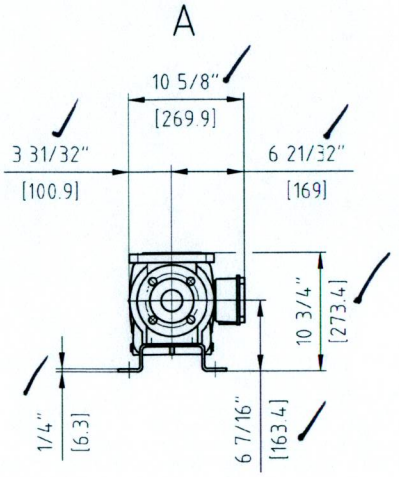

a) drilled acc. to

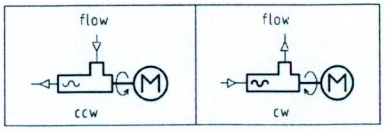

dimensions in [...] are in millimeter

Quant.	Denomination	Item	Material	Note	Weight / kg
1	baseplate	8200		Var.: 801-200/0020-D-100	19
1	drive: Nord SK22F-100LP	8100			47
1	pump: BN 2-24	8001			39

		Name	Day	Scale	Weight	Denomination
2021	Drawn	msk	15.07.	1:15	105 kg	dimensional drawing
	Checked	lsh	15.07.	EDP-No. 207441.dwg		Drawing-no. 262-C18/0020-D-711A4

SEEPEX.
ALL THINGS FLOW

General tolerances for dimensions without specified tolerances acc. to DIN ISO 2768-v