

Certified *AS BUILT Drawing Comm# 882244 BN 17-12 Cert drawing by: [signature] Date: 6.3.22

verbindlich für Kommissions-Nr.:
binding for comission-no.: 882244
date: 17.09.2021 signature: msk


Copyright: This drawing is our property and patented for us according to the law of copyright and associated rights !

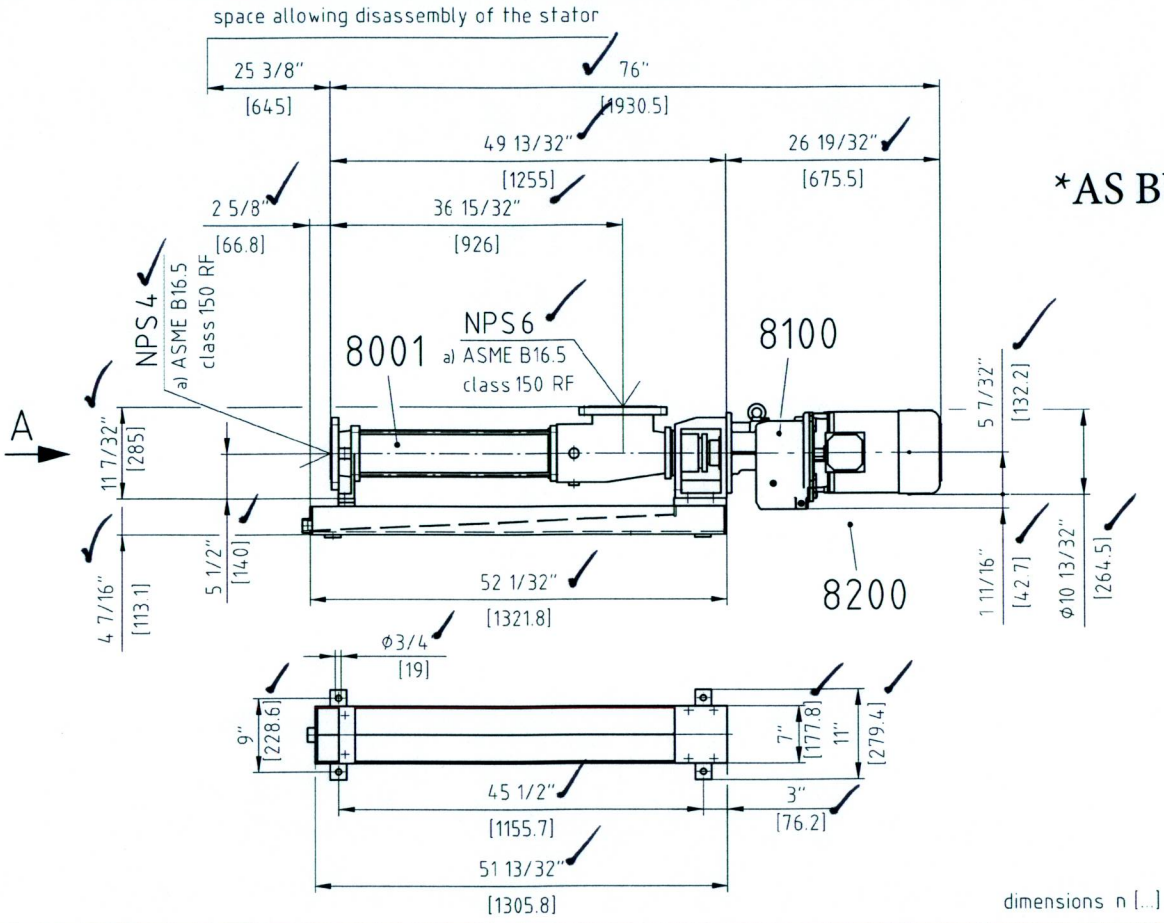

*AS BUILT

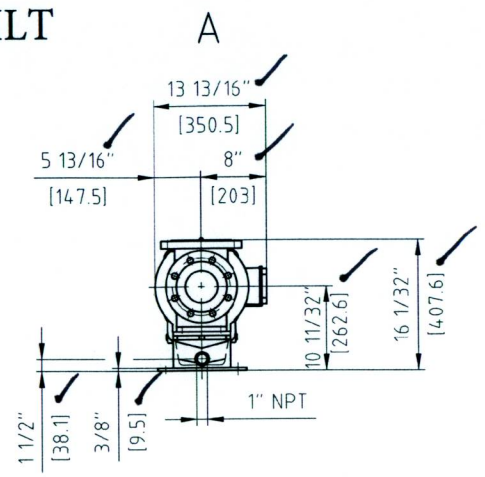

a) drilled acc. to

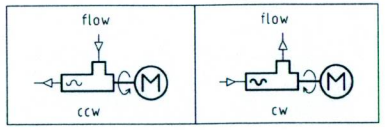

dimensions in [...] are in millimeter

Quant.	Denomination	Item	Material	Note	Weight / kg
1	baseplate:	8200		Var.: 801-200/0170-C-809	44
1	drive: Nord SK42F-132M.	8100			112
1	pump: BN 17-12 / 35-6L / 55-6LT / 30-12	8001			110

	Name	Day	Scale	Weight	Denomination
2021					
Drawn	msk	16.09.	◎▷ 1:20	266 kg	dimensional drawing
Checked	lsh	17.09.	EDP-No. 209687.dwg		Drawing-no. 262-D64/0170-C-700A4

SEEPEX.
ALL THINGS FLOW

General tolerances for dimensions without specified tolerances acc. to DIN ISO 2768-v