
Required Motor and termination box details.


Confirm the following:
1) Motor shall comply with IEEE 841
2) This motor should suitable to operate with VFD

Desmet Tag	Client Tag
PW534E.2/1	19-J-876A
PW534E.2/2	19-J-876B

Copyright: This drawing is our property and patented for us accordin


Provide a table for all the nozzles (size , rating , schedule, facing and projection)

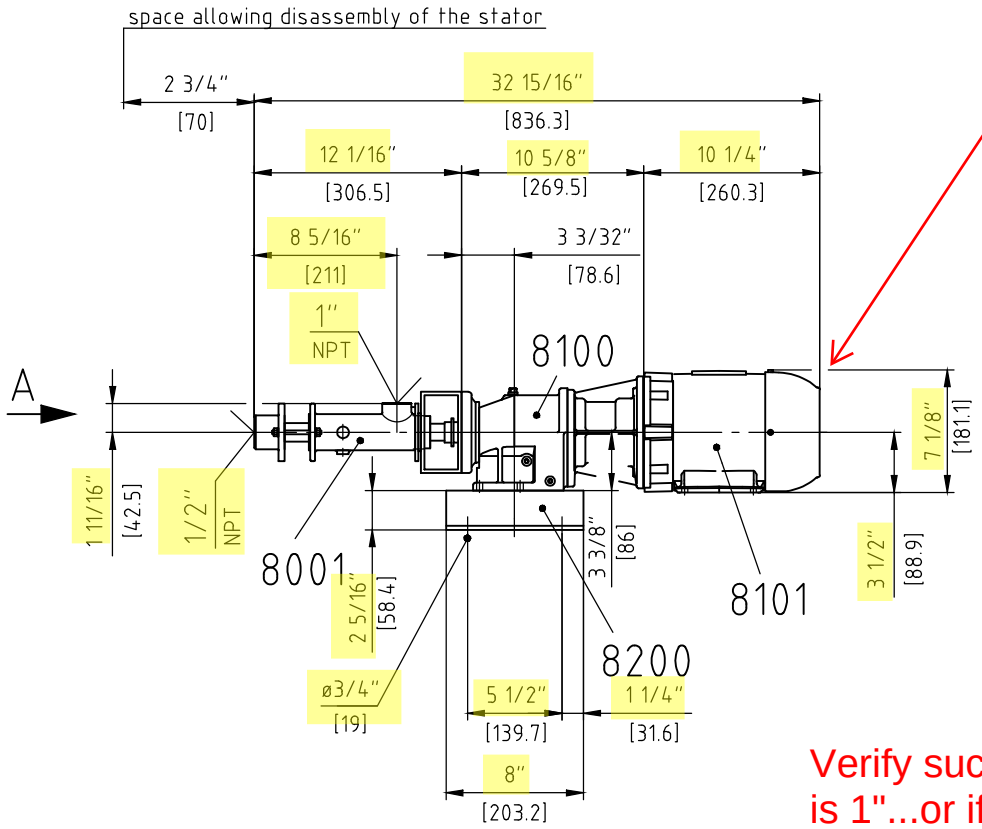

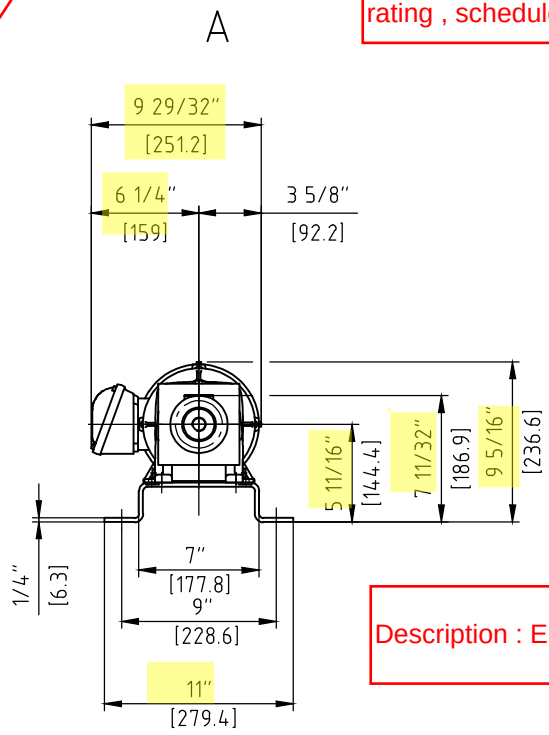

Description : Enzymatic Dosing Pumps

Verify suction is 1/2" and discharge is 1"...or if they need to be switched for the end suction arrangement.

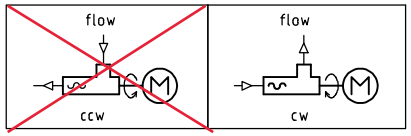

Quant.	Denomination	Item	Material	Note	Weight / kg
1	baseplate:	8200		Var: 820-200/M120-C-135	4
1	motor: WEG 00118ET3E143TC-W22	8101			20
1	gear: Nord SK02XF-140TC	8100			17
1	pump: MD 003-12 / 0005-24 / 0015-24	8001			4

	2018	Name	Day	Scale	Weight	Denomination
SEEPEX. ALL THINGS FLOW	Drawn	cbo	30.05.	1:10	45 kg	dimensional drawing
	Checked	lsh	31.05.	EDP-No. 172723.dwg		Drawing-no. 103-C20/M030-C-720A4

General tolerances for dimensions without specified tolerances acc. to DIN ISO 2768-v