
Copyright: This drawing is our property and patented for us according to the law of copyright and associated rights !

verbindlich für Kommissions-Nr.:
binding for comission-no.: 882043
date: 30.08.2021 signature: lsh

WORLD ENERGY TAG 19-J-876B
DESMET TAG PW534E.2/2

PROJECT - WORPAR
ITEM NBR - PW534E.2/2
TYPE - ASSY
eB NBR - 100212178.002
DATE - 25.03.2022

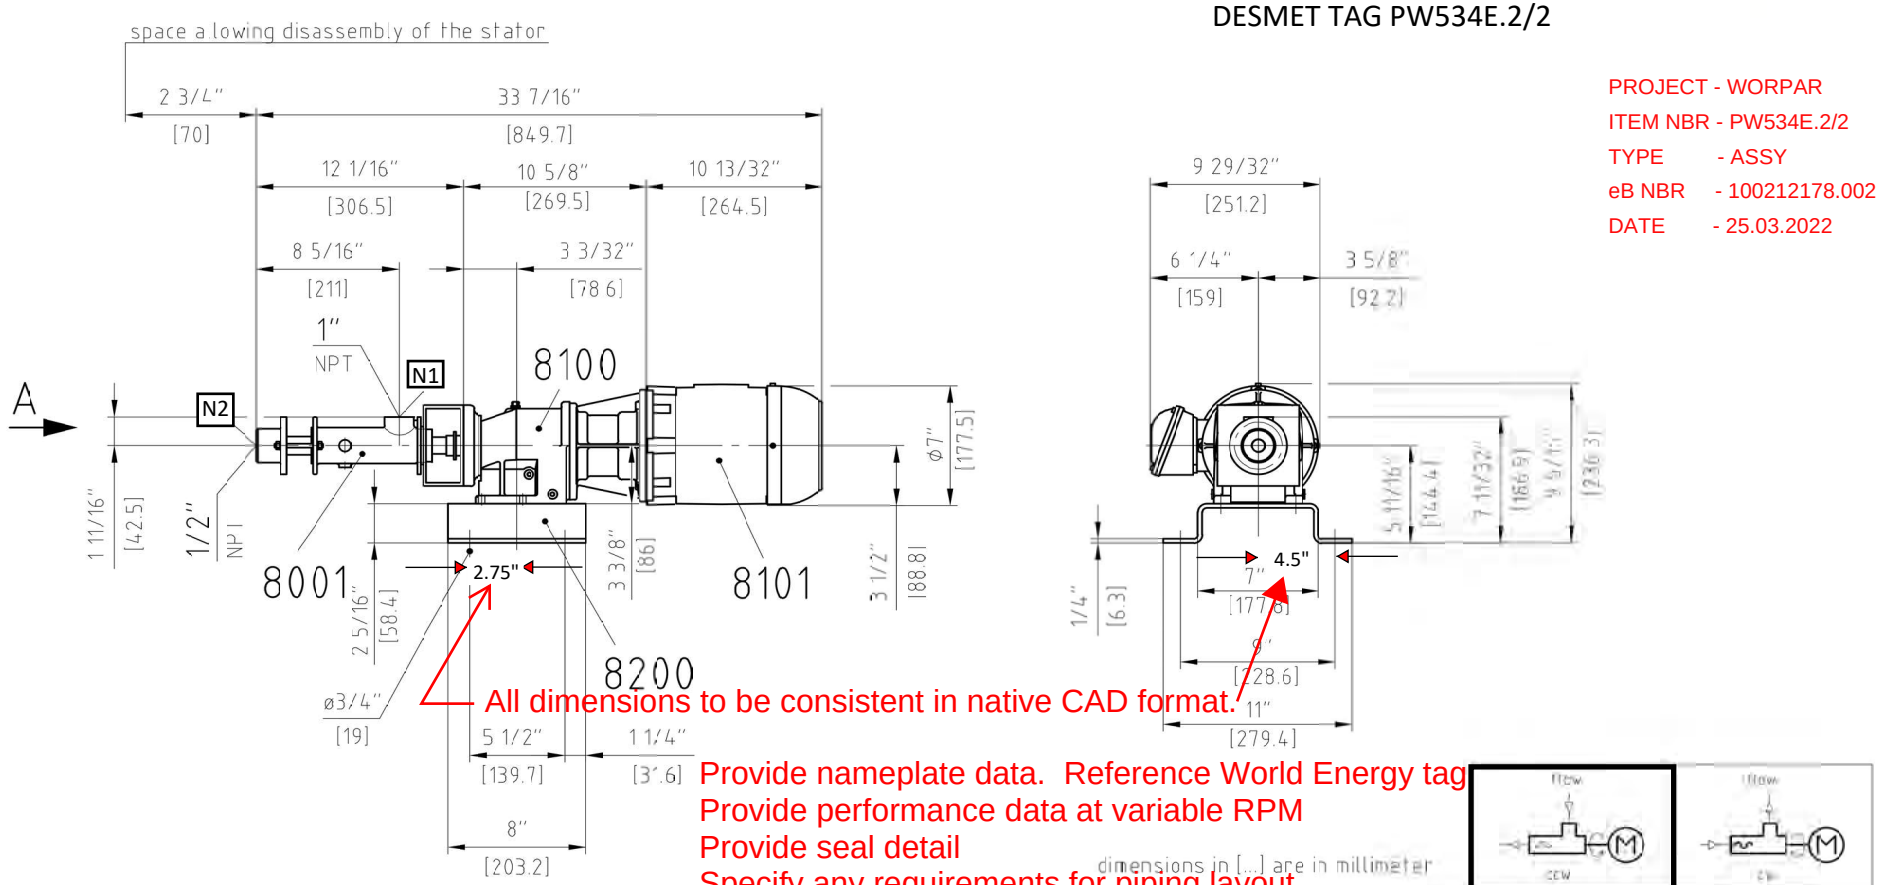


| Quant. | Denomination | Item | Materiel | Note | Weight / kg |
|---|---|---|---|---|---|
| 1 | baseplate: | 8200 | | Var: 820-200/M120-C-135 | 8.8 |
| 1 | motor: WEG 00118ET3ER143TC | 8101 | | | 41.8 |
| 1 | gear: Nord SK02X=-140TC | 8100 | | | 37.4 |
| 1 | pump: MD 003-12 / 0005-24 / 0015-24 | 8001 | | | 8.8 |

| | | Name | Day | Scale | Weight | Denomination |
|---|---|---|---|---|---|---|
| 2021 | Drawn | lsh | 30.08. | 1:10 | 97 LBS | dimensional drawing |
| | Checked | gf | 30.08. | EDP-No. 208440.dwg | | Drawing-no. 103-C20/M030-C-730A4 |

SEEPEX.
ALL THINGS FLOW

General tolerances for dimensions without specified tolerances acc. to DIN ISO 2768-v