
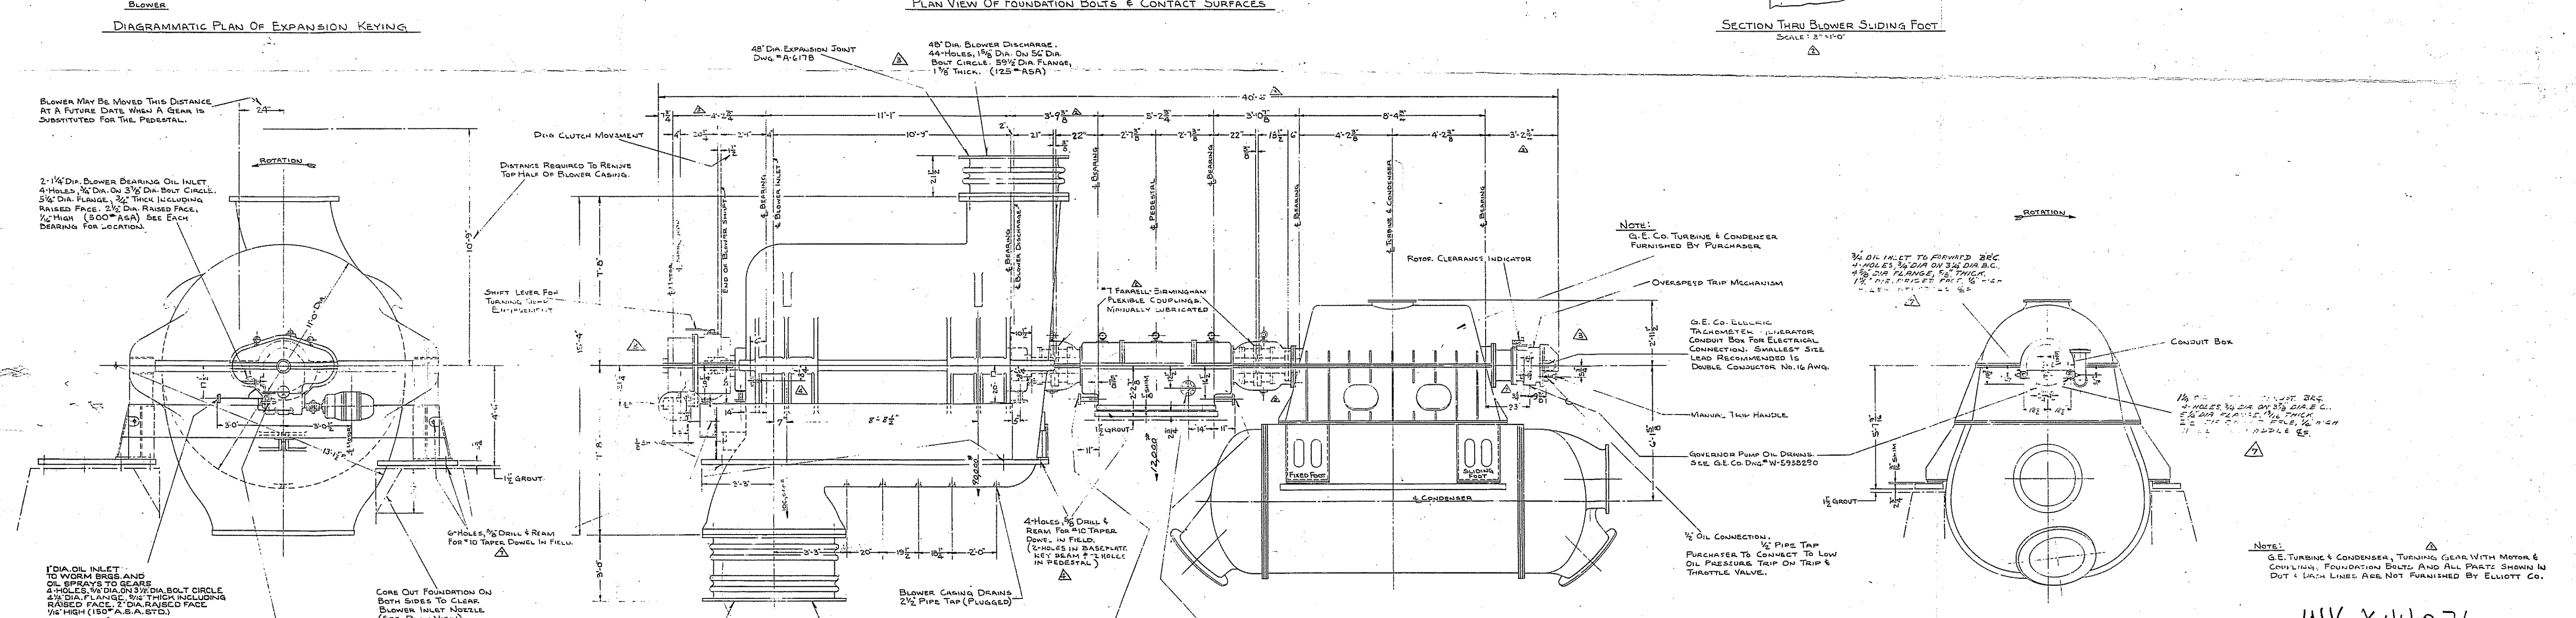


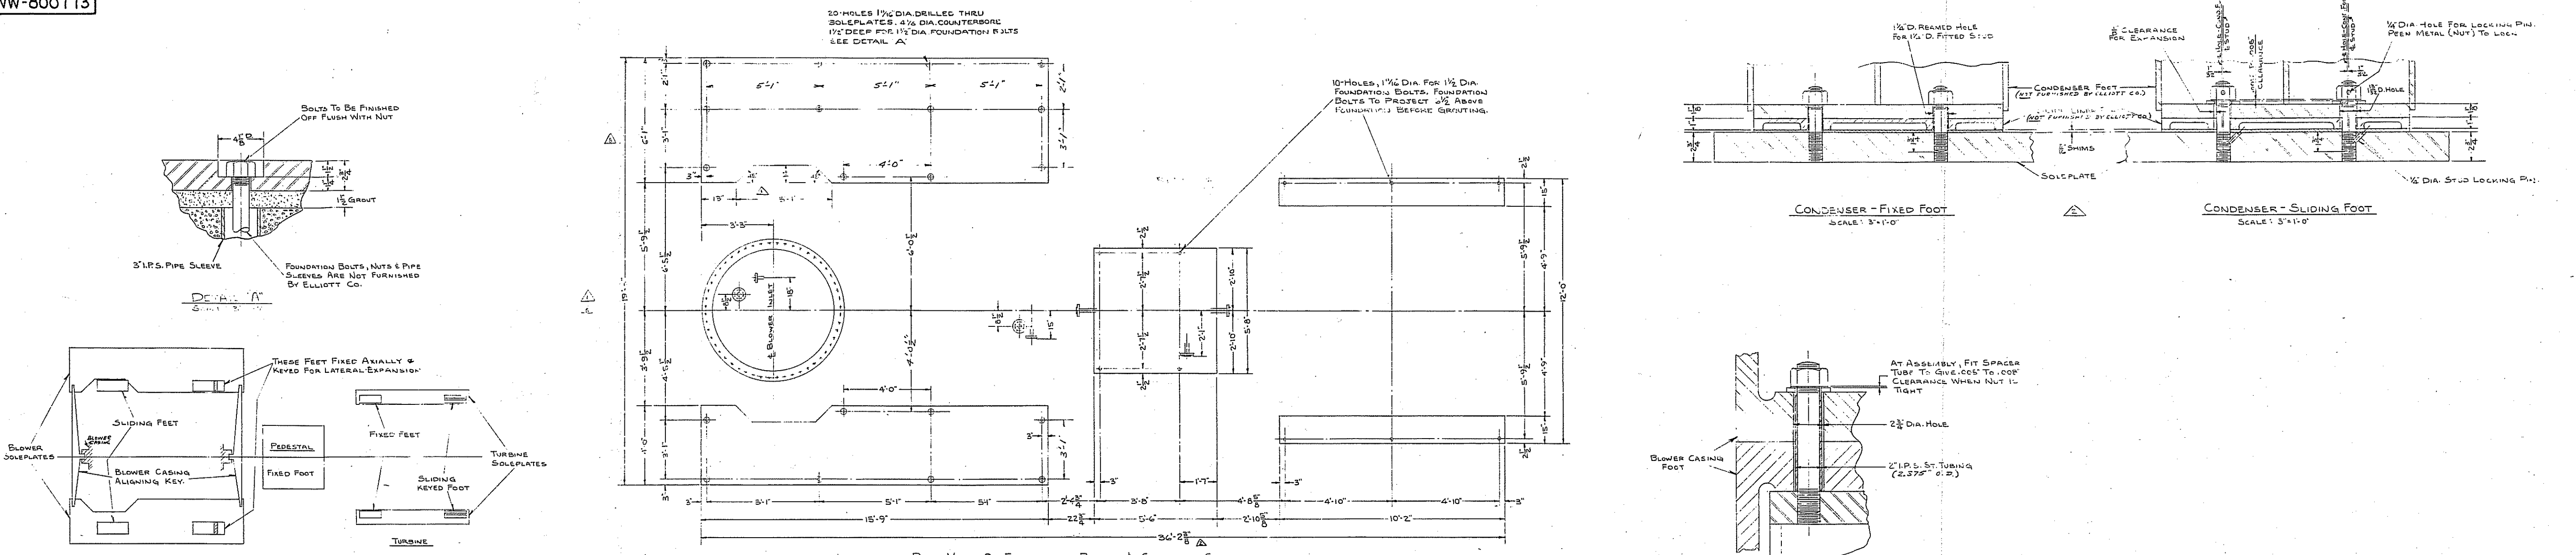

11V X 44076

REVISIONS		OUTLINE	
1	REVISED WITH DATA	110-M-B Blower With G.E. Co. Turbine	
2	REVISED WITH DATA	DATE: 10-26-49	SCALE: 1/2"=1'-0"
3	REVISED WITH DATA	DATE: 10-26-49	SCALE: 1/2"=1'-0"
