











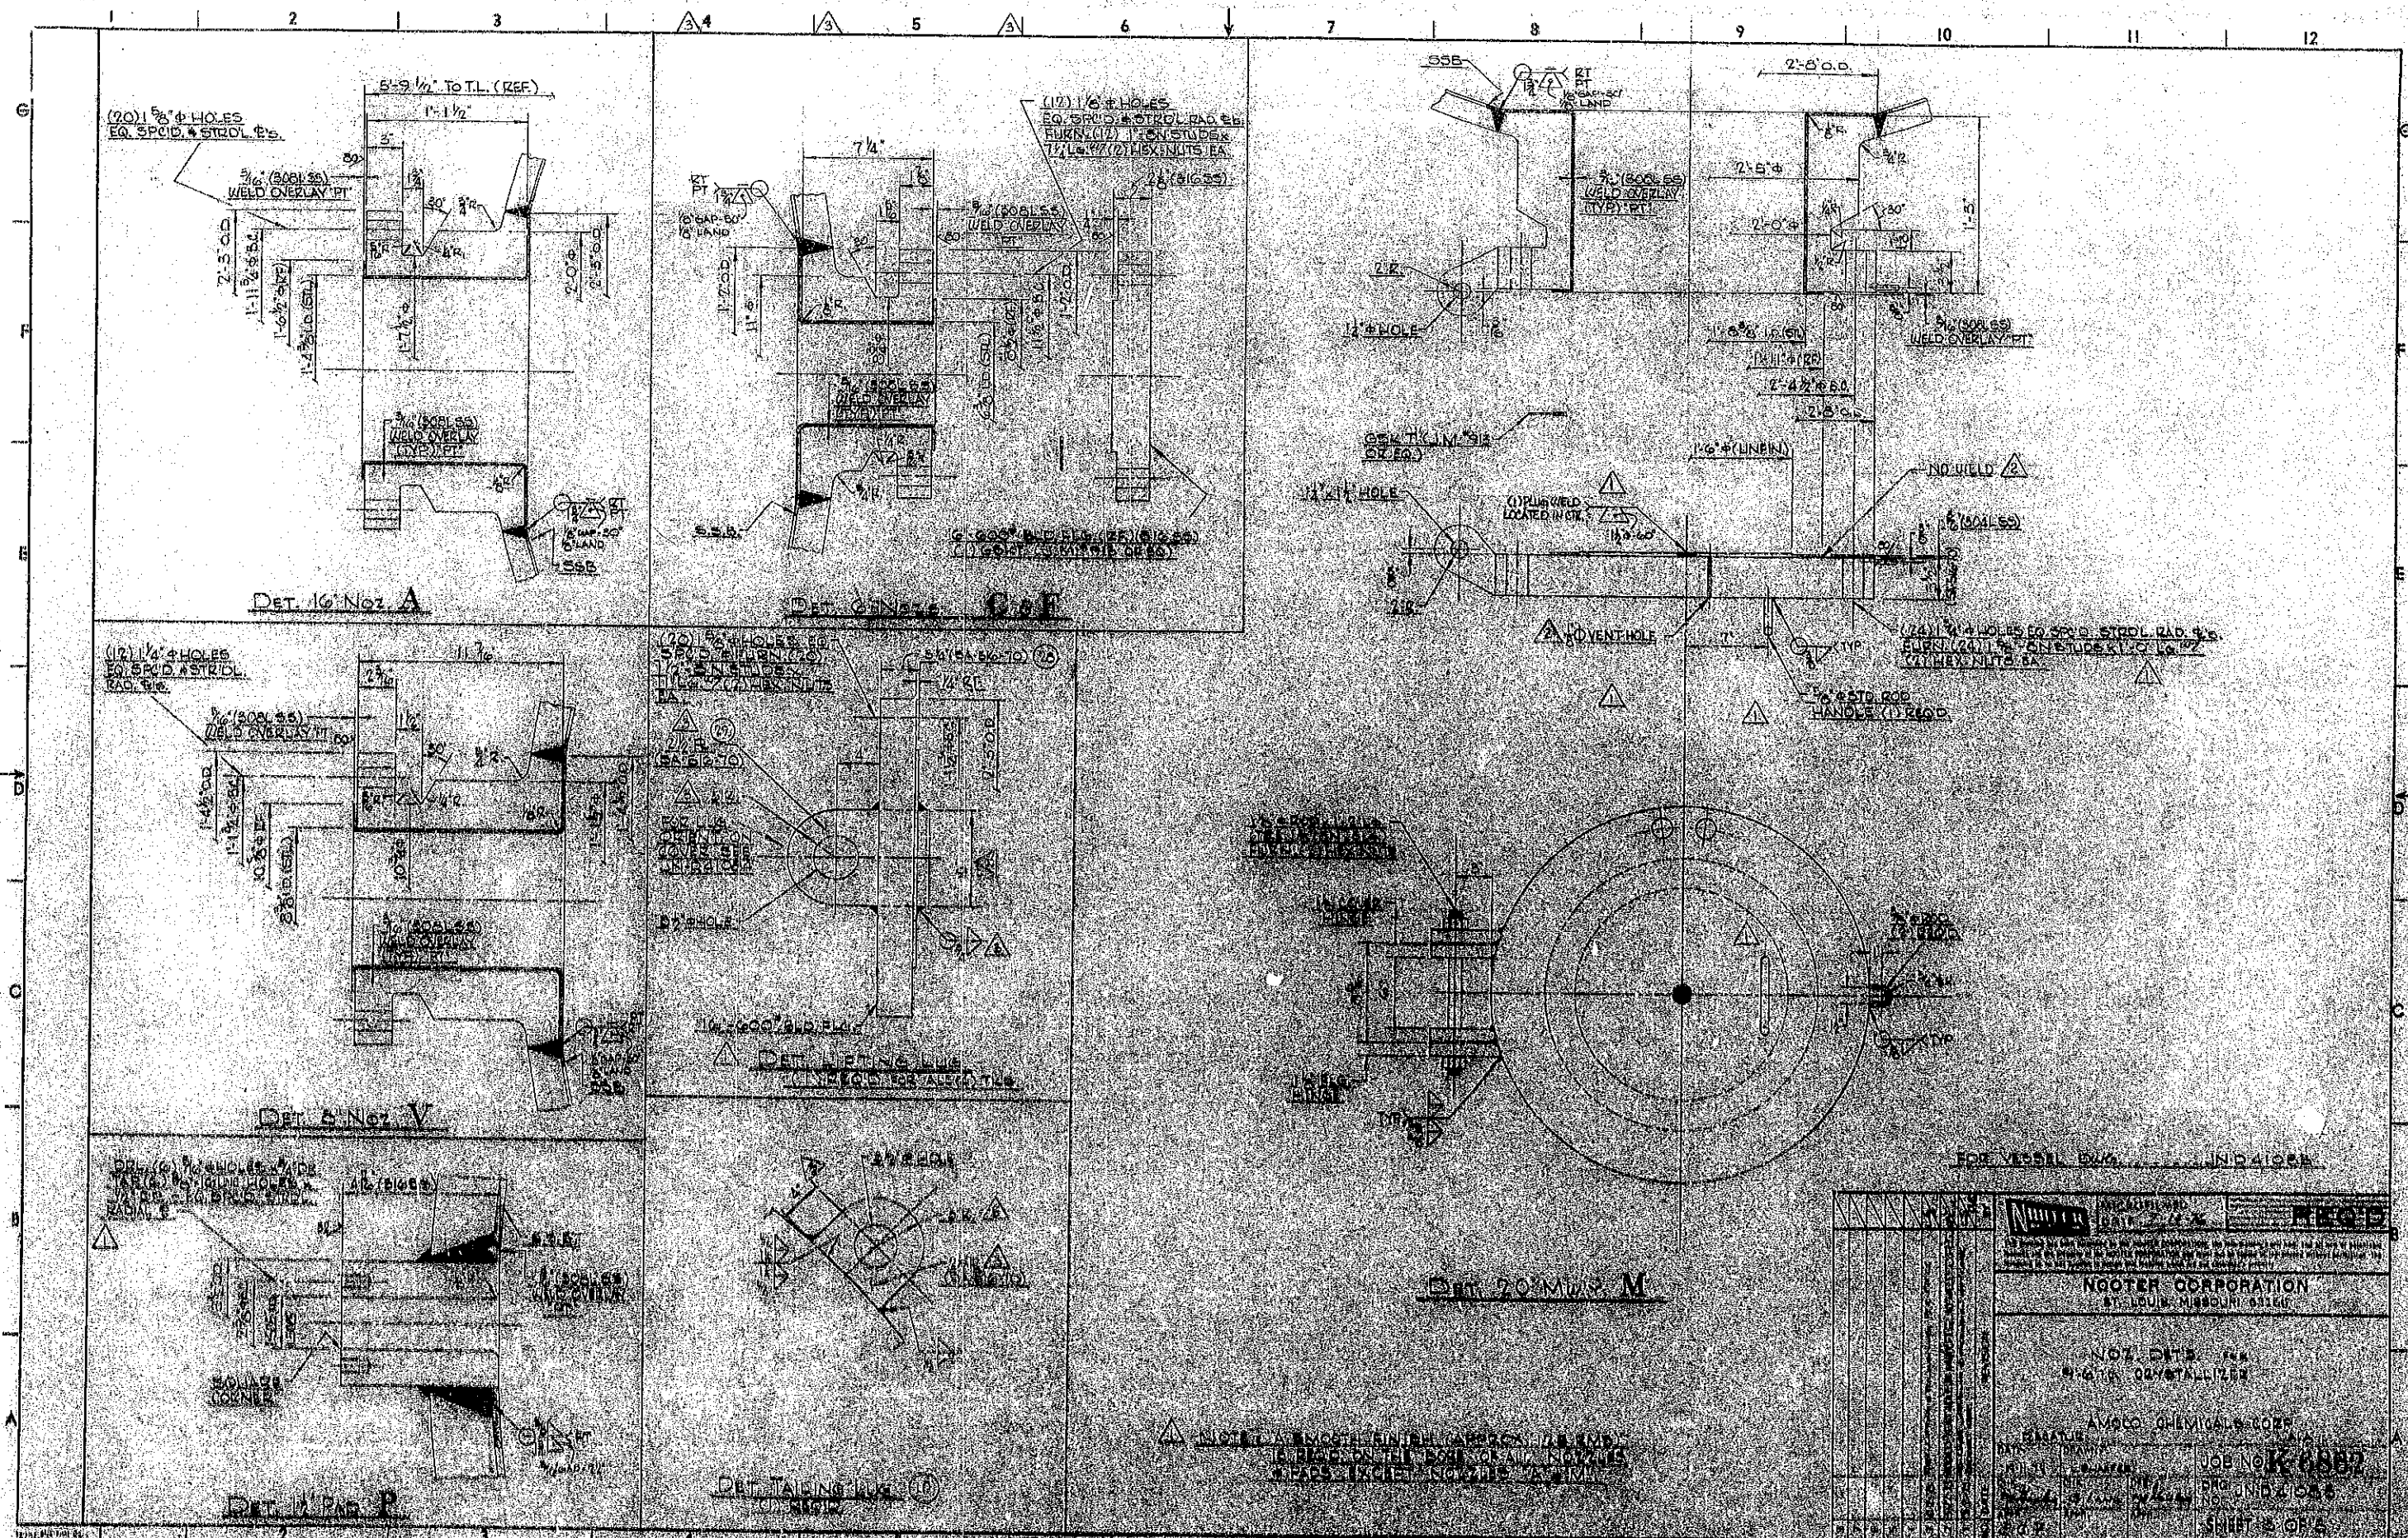








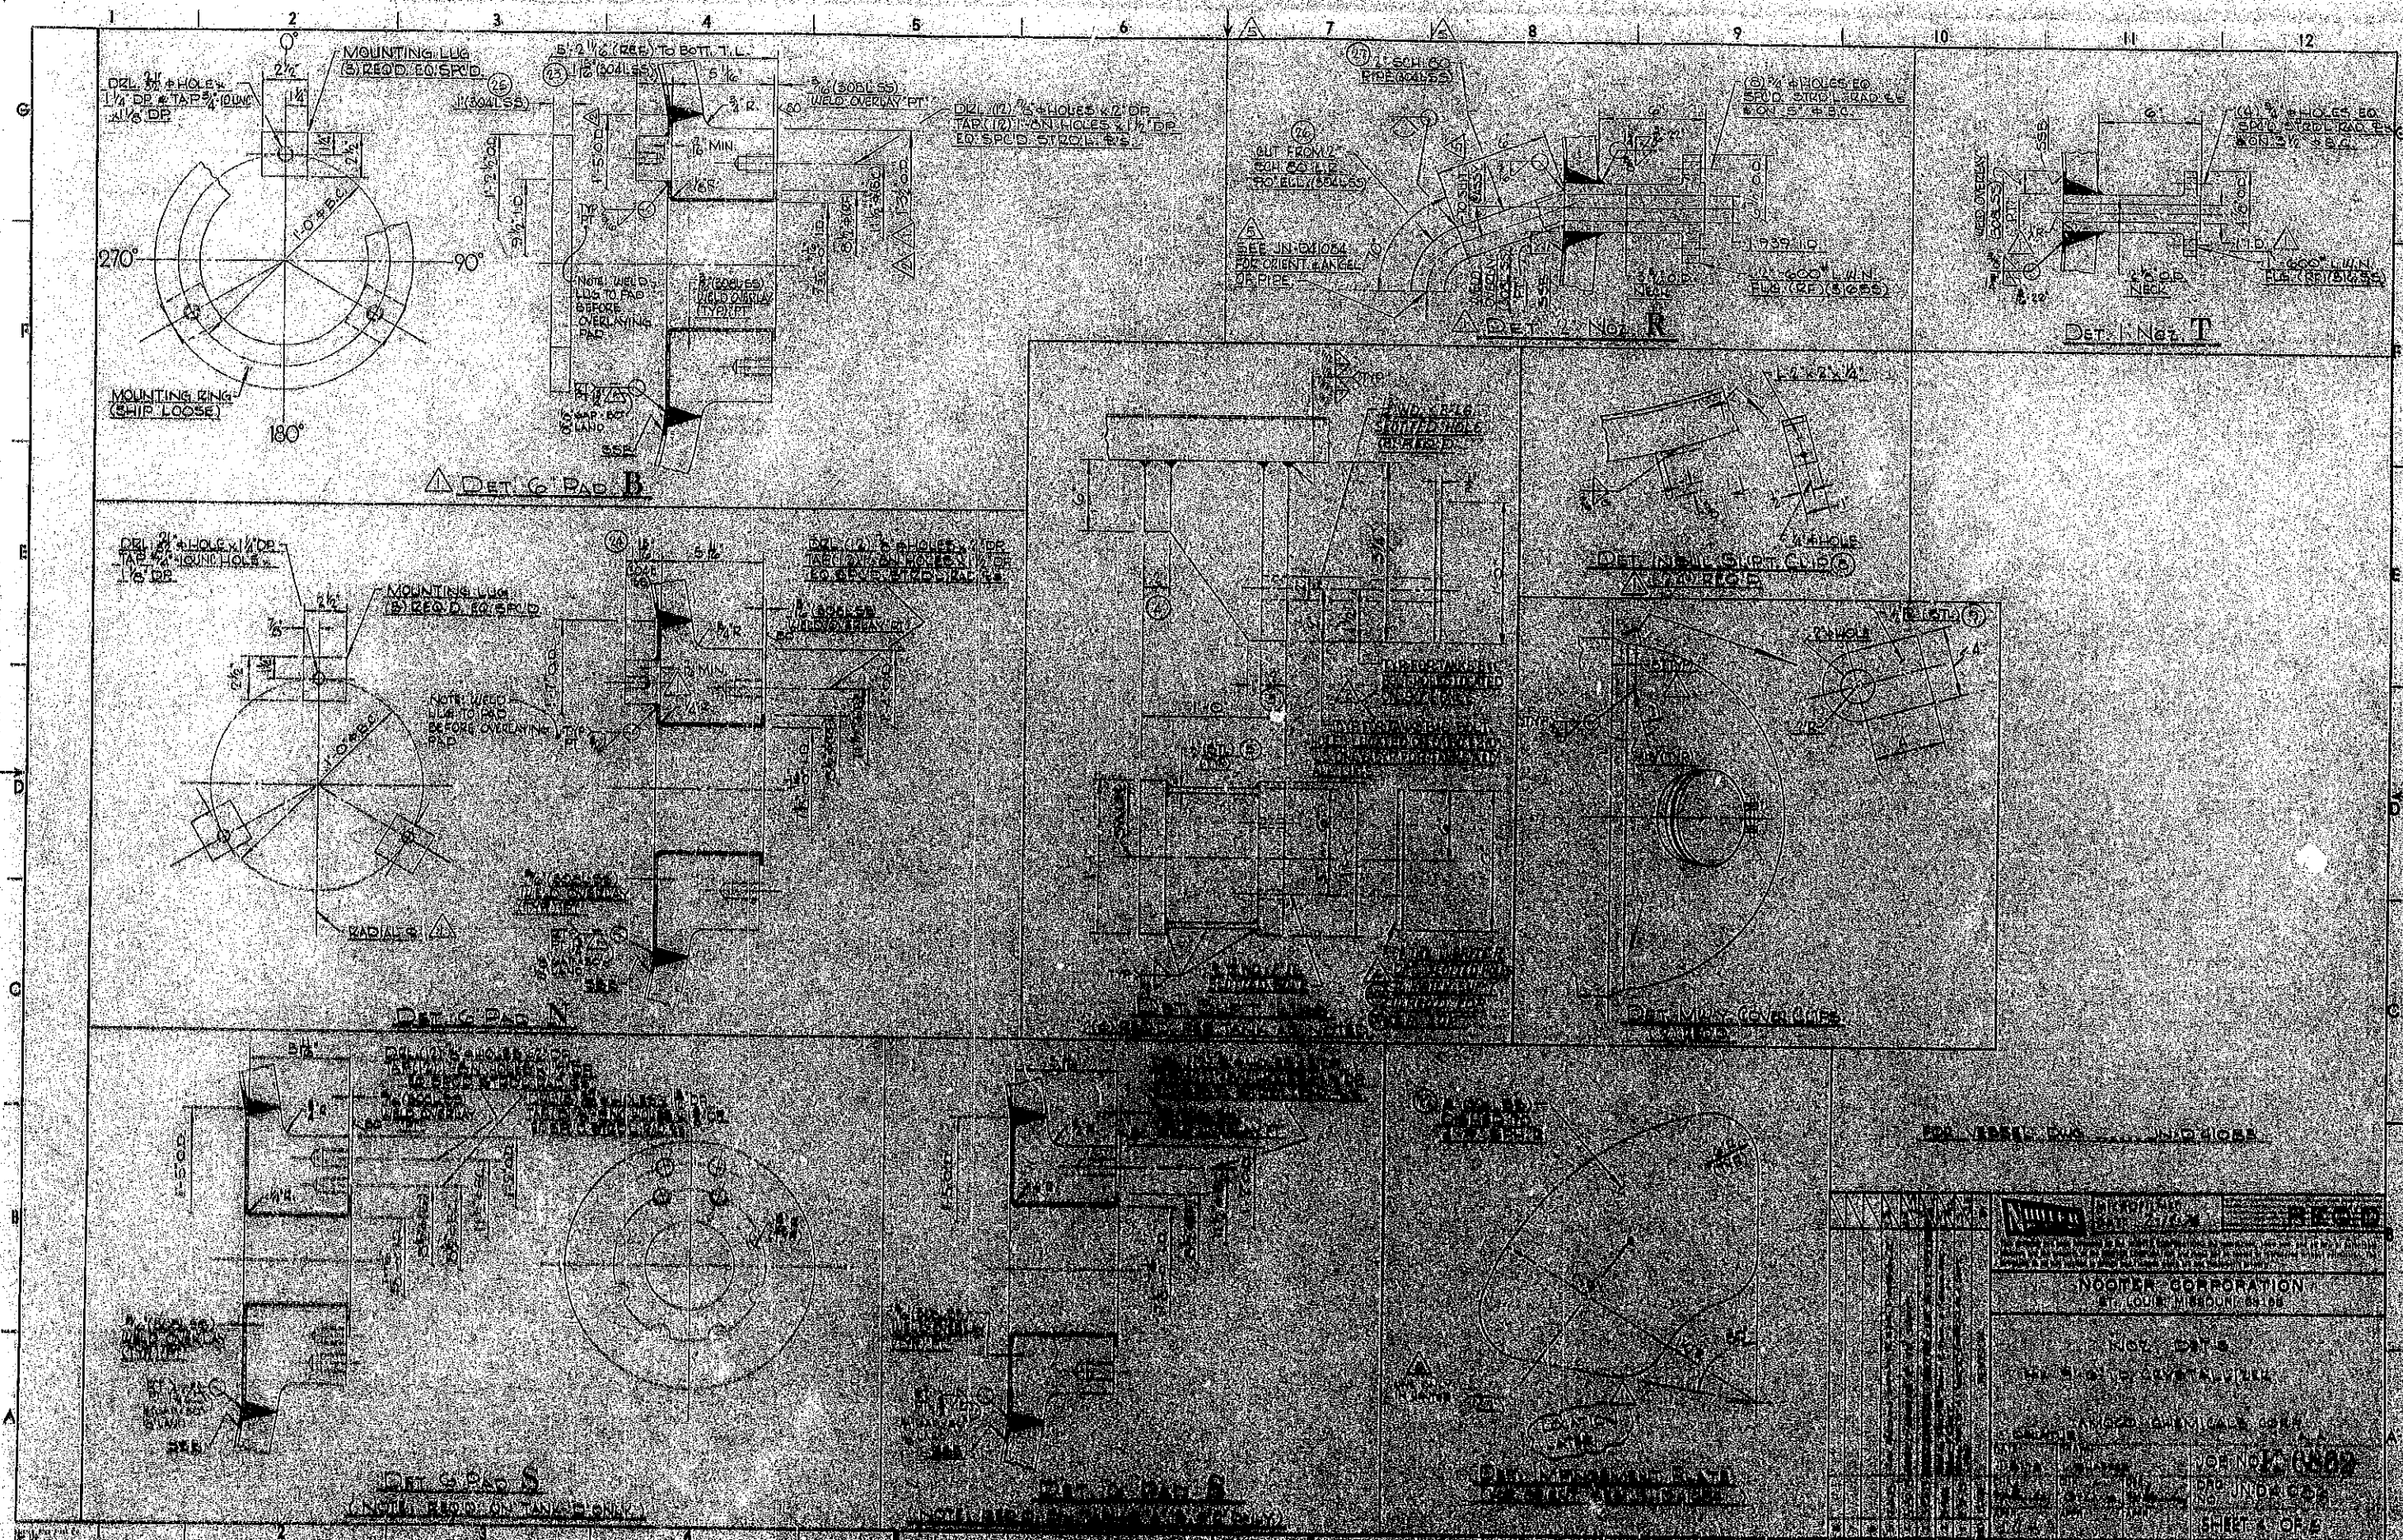







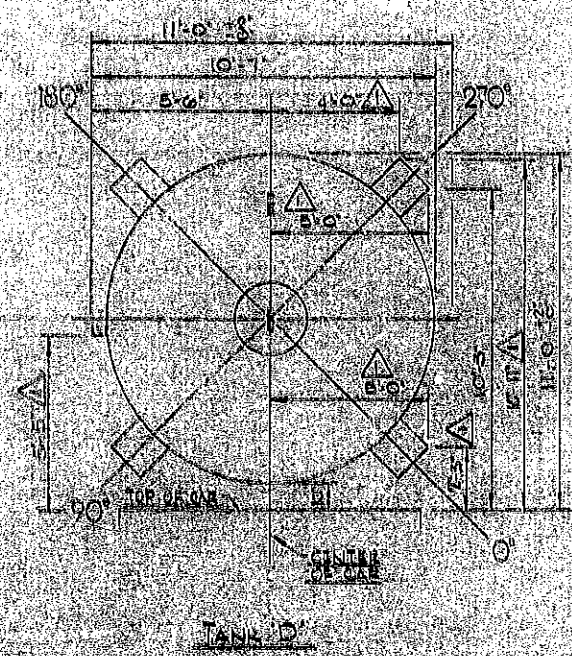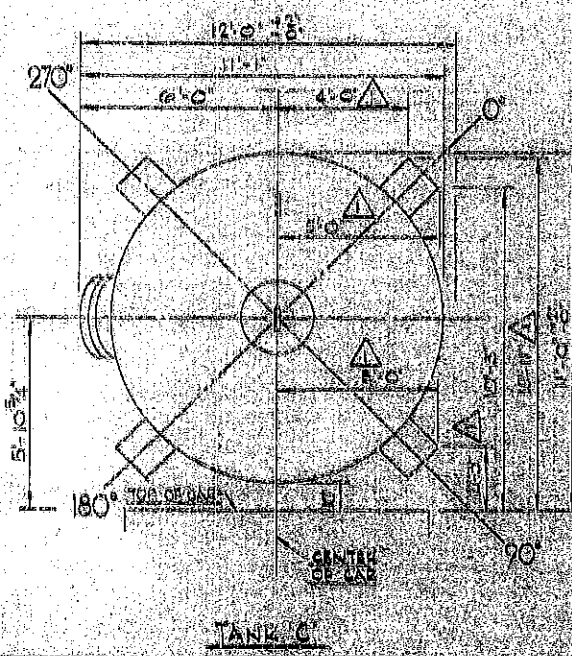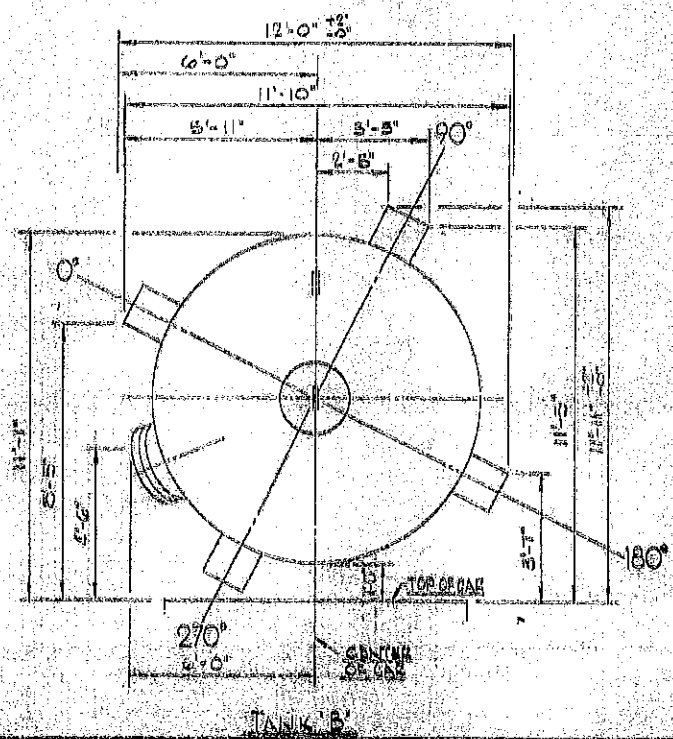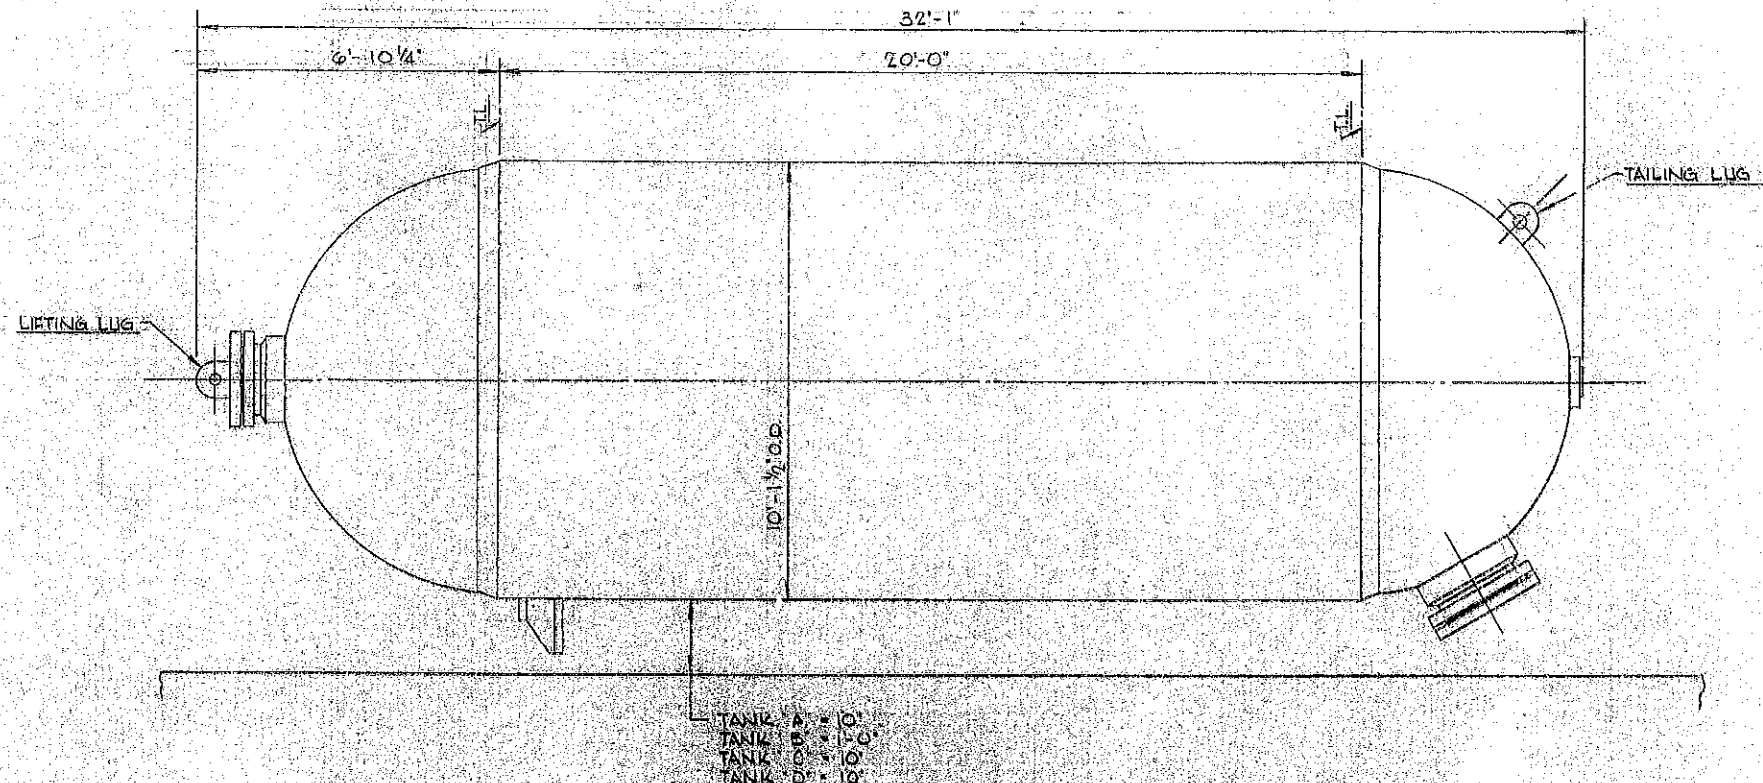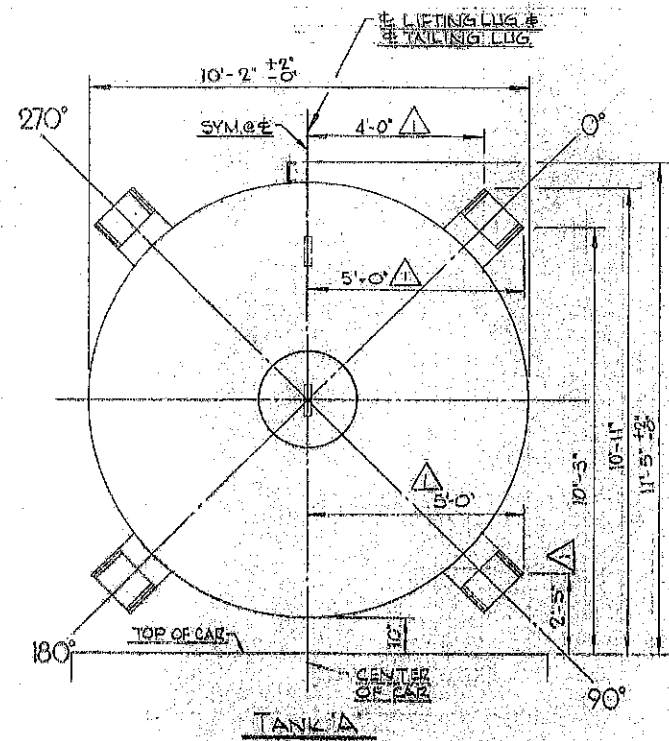

SHIPPING WT. \* 124,000\* APPROX.  
DESTINATION: DECATUR, ALA.

FOR VESSEL OWN. IN CHARGE

|                                                 |                                            |
|-------------------------------------------------|--------------------------------------------|
| NOOTER CORPORATION<br>ST. LOUIS, MISSOURI 63106 |                                            |
| SHIPPING DOW.<br>NO. 574 IN CRYSTALLIZER        |                                            |
| AMMONIUM CHLORIDE CORP.                         |                                            |
| CHARGE<br>DATE<br>BY<br>APPROVED<br>DATE        | RECEIVED<br>DATE<br>BY<br>APPROVED<br>DATE |
| JCB NO. K-6862<br>NO. JND 4 574<br>SHEET 1 OF 1 |                                            |