


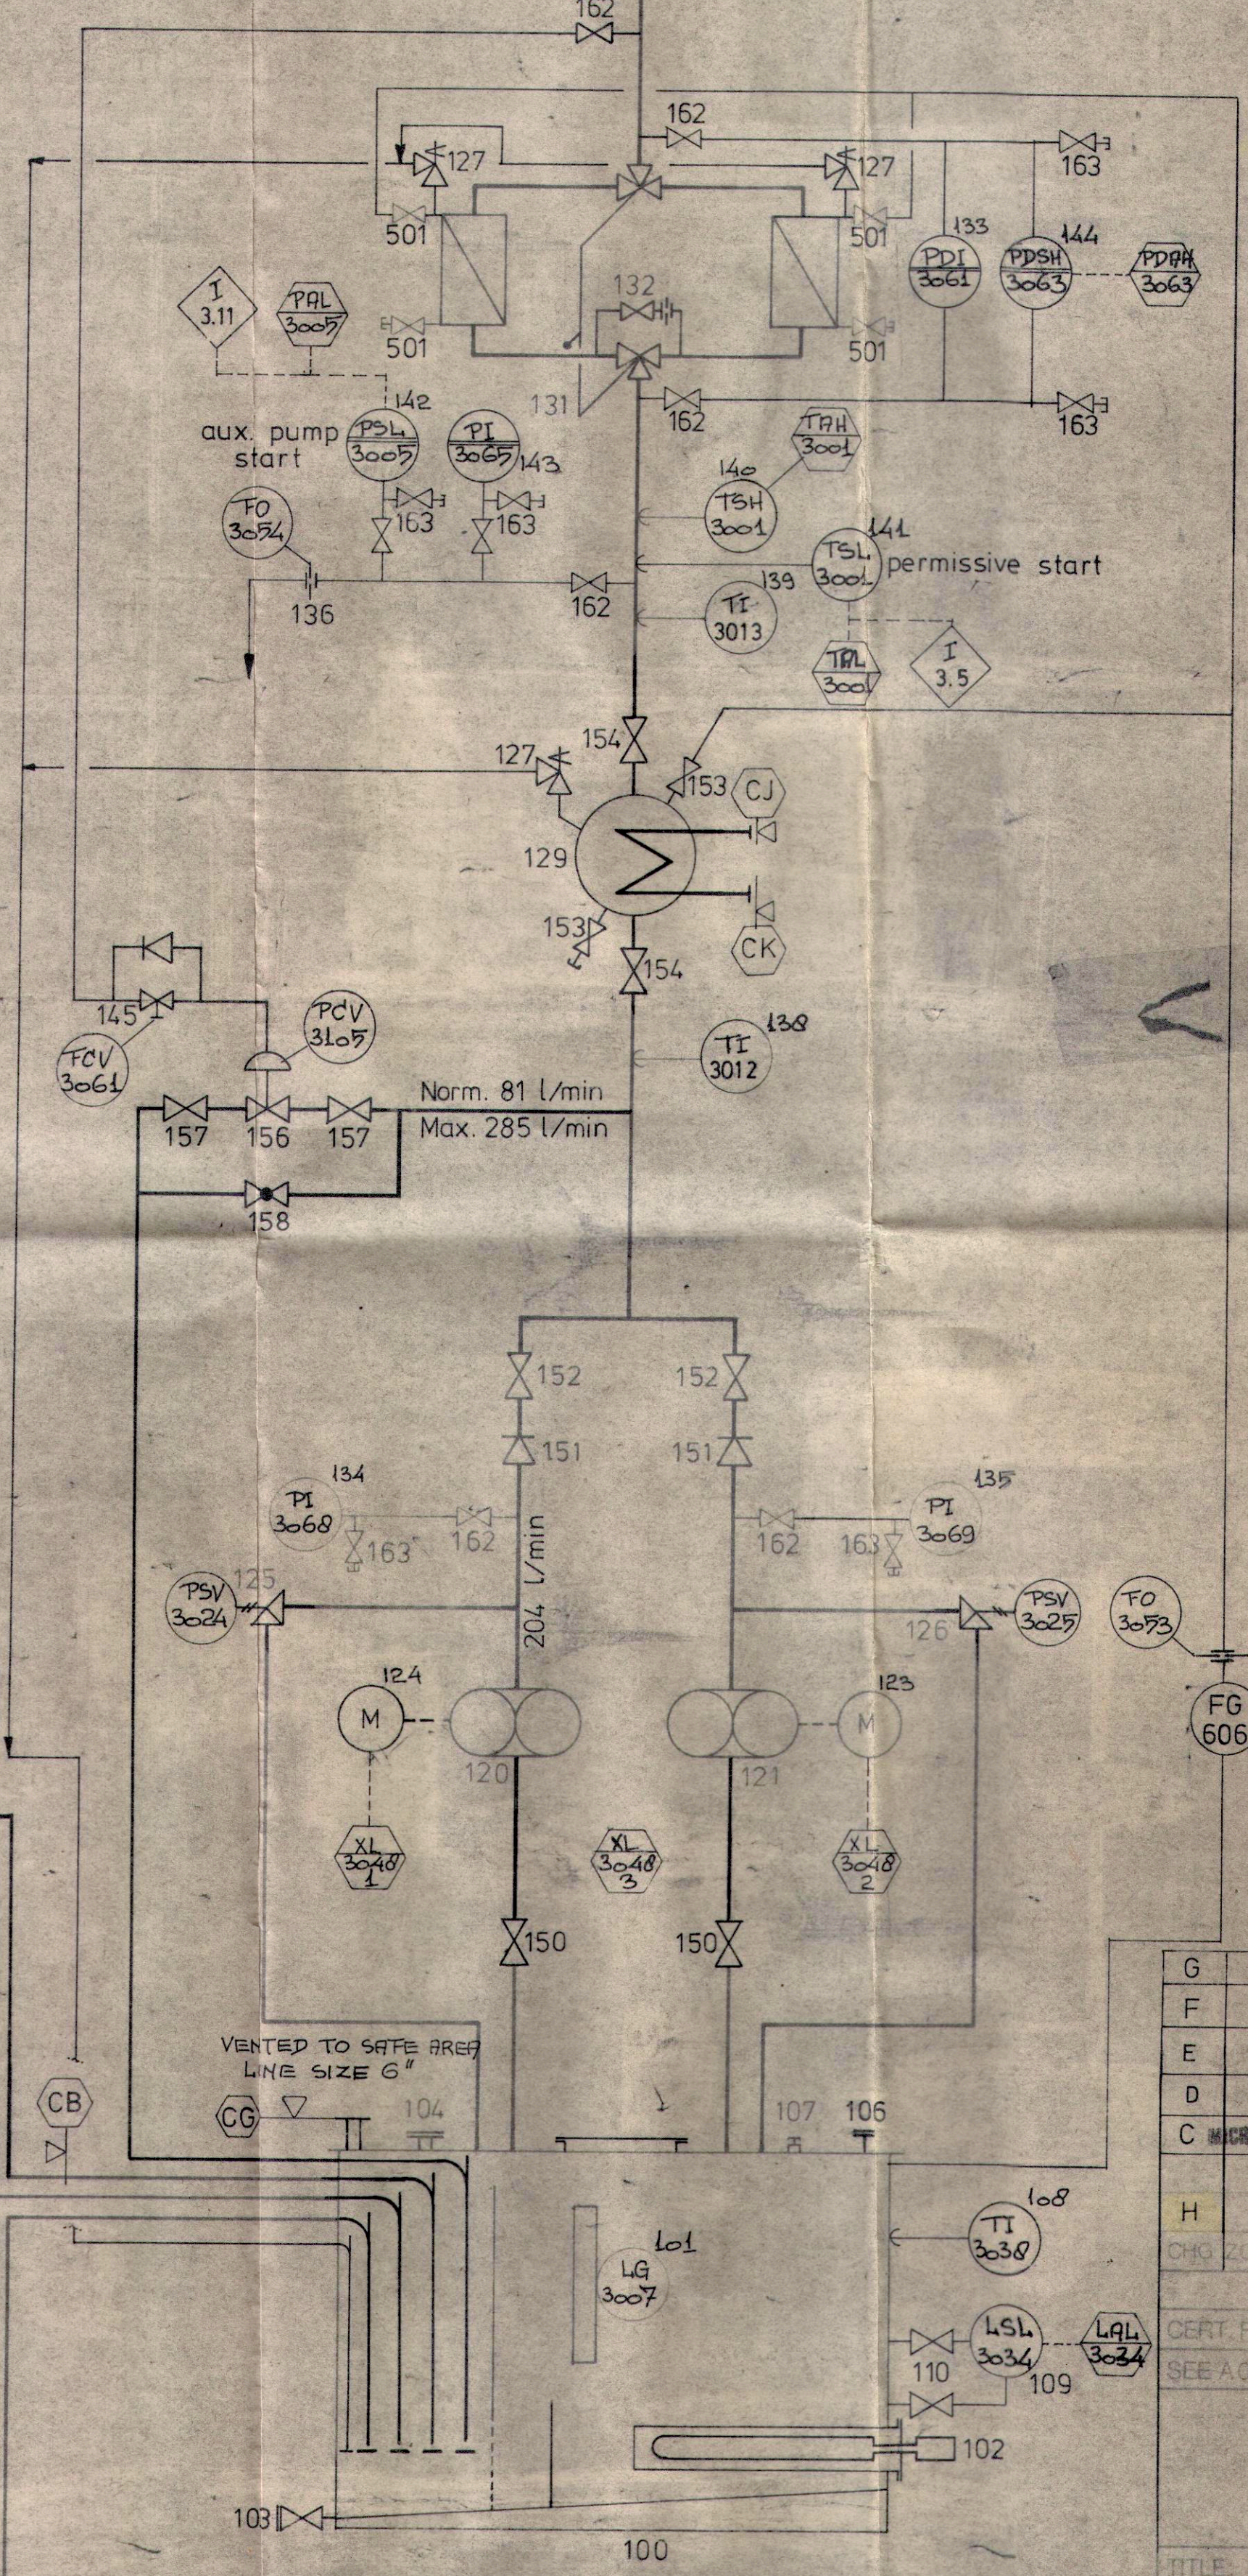

MAIN PANEL MOUNTED

CUSTOMER ☒ DLS

INTERCONNECTING POINTS

NOTE: INTERCONNECTING
PIPING BY CUSTOMER

C.J.B. (PROJECTS) LTD.
FOR H.D.P.E PLANT FOR GPSA GREECE
C.J.B. PROJECT Nr. 4110
D.L.S. ORDER Nr. LC0261
C.J.B. ORDER Nr. 4110 / A / 4 / 30 / 01
C.J.B. D.W.C. Nr. 4110 / C = 430 / 11

CJB (PROJECTS) LTD.
FINAL
SIGNATURE: *[Signature]* DATE: 4/1/83

G	3 Relief valves item 127 added	4.11.82	P.v.d. Kleijn	
F	Terminal points	5.2 Sept 82	P.v.d. Kleijn	
E	CHECK VALVE AND TAG Nrs. ADD	June 82	G.S.	
D	UPDATED	Apr 82	G.S.	
C	Buffer gas instrumentation	1.3.82	P.v.	
H	Relief valve / vent on degassing tank	Dec 82	G.S.	
CHG. ZONE		ALTERATIONS	DATE	BY
CERT. FOR CONSTR.		SEE A 06212 FOR VOL. 8 ETC. NOT SPECIFIED		
		FIRST ORDER	LC 0261	
		REF DWG		
HENGELO (OV. NETHERLANDS)		PROJ. METHOD		
TITLE: LUBE AND SEAL OIL DIAGRAM				
DRAWN v.d. Kleijn		04-81	SCALE	—
CHK		"	SHEET NO.	1 OF 1
ISSUED		25.11.09-81	IND	
PVB		TOGER TEK		
COPYRIGHT IS RESERVED BY LAW		C 0261.59B 000		