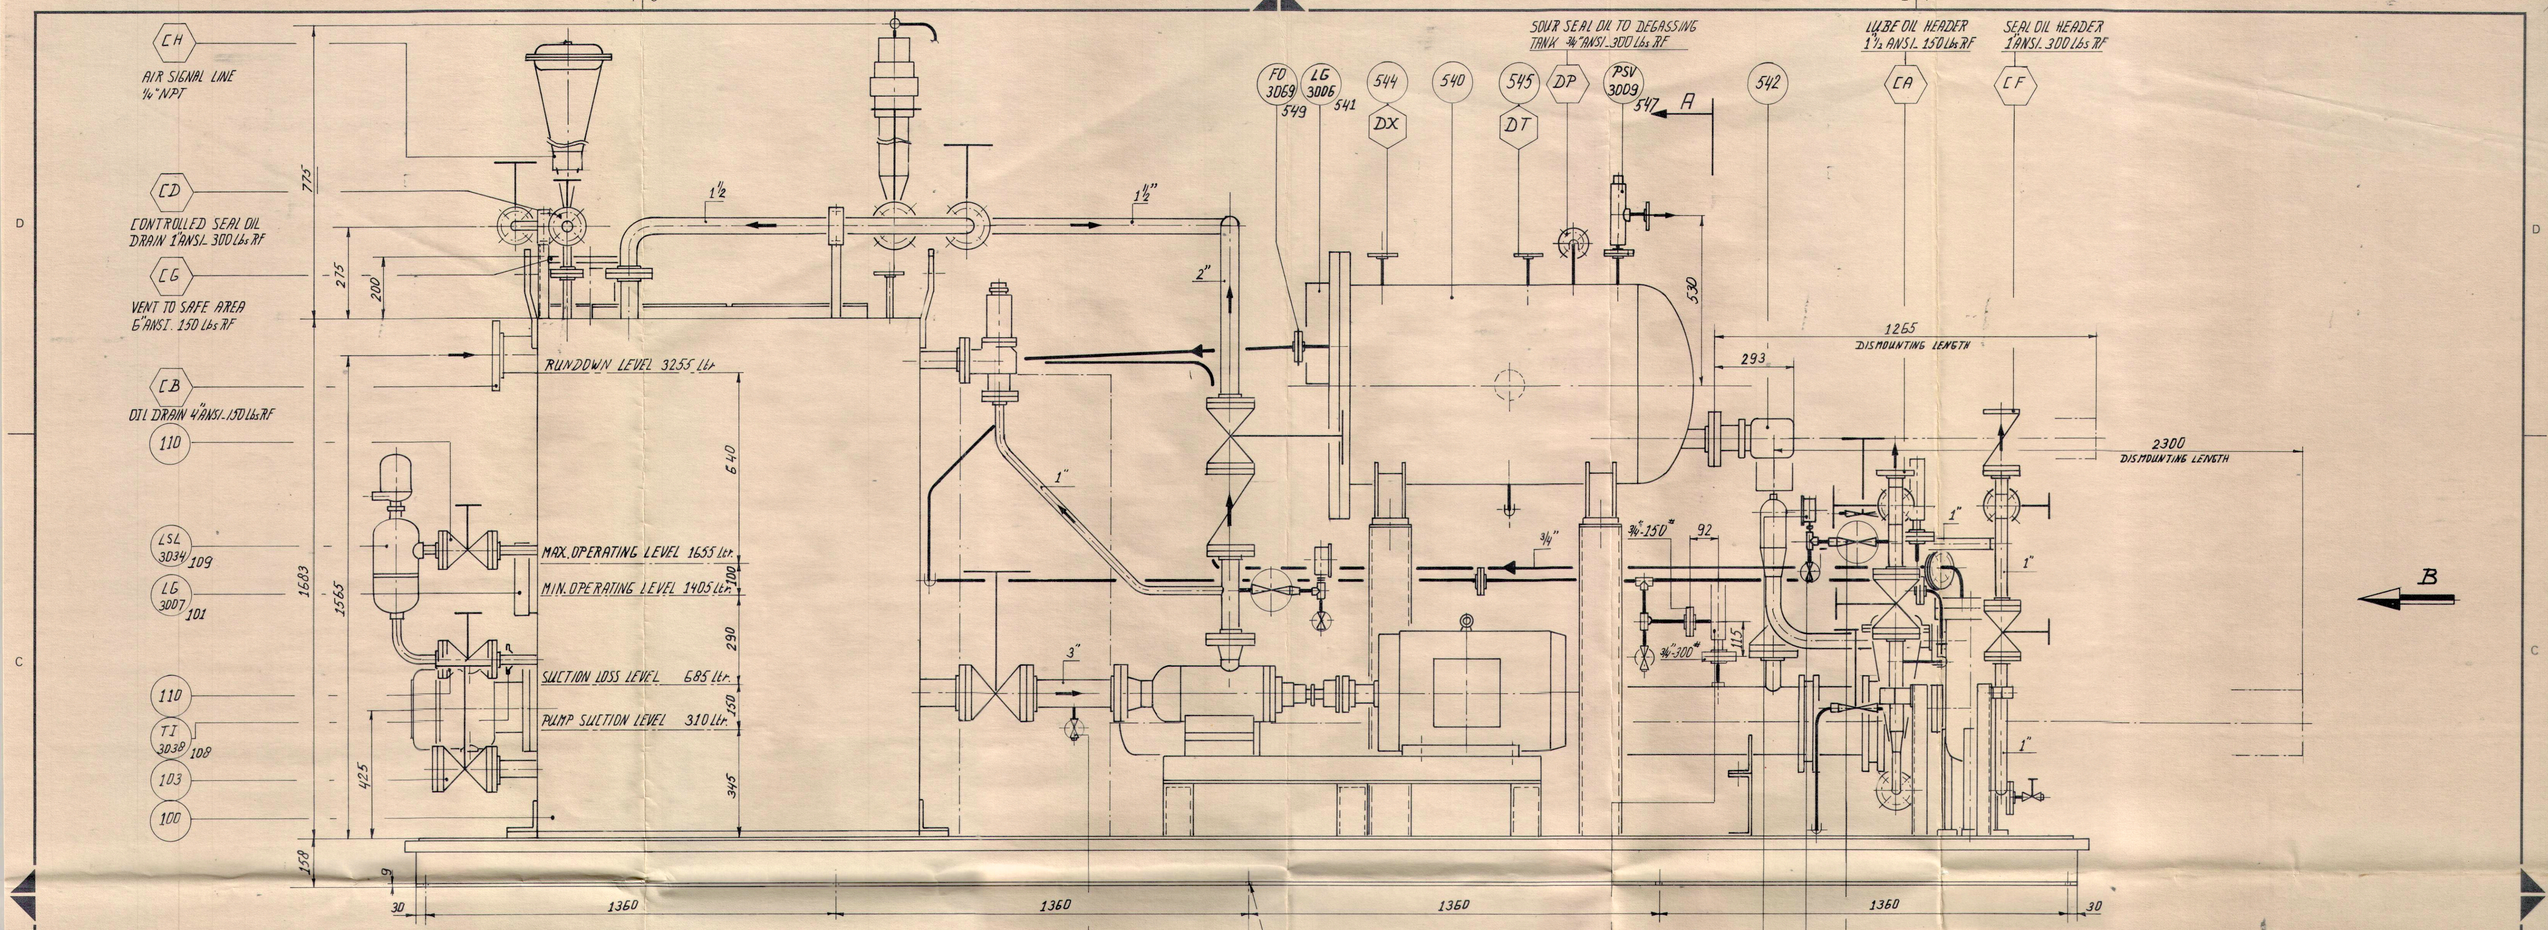

CJB (PROJECTS) LTD
FOR GREEK PETROCHEMICAL S.A.
PETROCHEMICAL COMPLEX
ACHELOOS ESTUARY GREECE
ITEM NR. C 430
DLS ORDER NR. LC 0261
CJB PROJECT NR. 4110
CJB PURCHASE ORDER NR. 4110/A/4/30/01
CJB DWG NR. 4110/C - 430-7 REV G

DELAVAL-STORK V.O.F.
THIS DRAWING IS FOR:
☐ INFORMATION ONLY.
☐ APPROVAL PRIOR TO MANUFACTURE OR PURCHASE OF MATERIAL.
(REQUIRED BY TO ASSURE MAINTAINING PRESENT SCHEDULE)
☐ RECORD APPROVAL ONLY.
☐ FINAL DISTRIBUTION.
✕ As Built
DATE: 13. FEB 1983
SIGN.:

CJB (PROJECTS) LTD.
FINAL DRAWING
SIGNATURE J.H. Weber DATE 8/2/83

CHG	ZONE	ALTERATIONS	DATE	BY	CHK	WHY	BEDR
F		DRAWING UPDATED	31.1'93	K.A.			
E		RELIEF VALVE ON FILTER AND COOLER ADDED RELIEF VALVE PUMP CHANGED	26 OKT '92	K.A.			
D		DIMENSIONS RELIEF VALVE ITEM 547 CHANGED. SWD-LSD 1.92-190	19 OKT '92	K.A.			
C		COOLER DIMENSION CHANGED ADDED ITEM 433 CHECK VALVE	24 SEP '92	K.A.			
B MICRO		CHANGED LOCATION T2 ITEM 548 CHANGED VALVE 156	3 MAR '92	K.A.			
A		CHANGED NOZZLE A ADDED DIR. ON DEG. DWG.	20 FEB '92	K.A.			

0 1 2 3 4 5 6 7 8 9 10 cm.

CERT. FOR CONSTR.: C. Kamb

SEE A0621.2 FOR TOL'S ETC. NOT SPECIFIED

DELAVAL STORK
HENGELO (OV.)
NETHERLANDS

FIRST ORDER: LC 0240
REF. DWG.:
PROJ. METHOD:

TITLE: LUBE - SEAL OIL CONSOLE

DRAWN	K.A.	NOV '81	SCALE:	1 : 10
CHK.	T.M.	" "	SHEETNO.	2 OF 2
ISSUED	C.J.K.	9/3-82	NO.:	C 0261 - 60.3000
PVB.		GER.TEK.		

COPYRIGHT IS RESERVED BY LAW.