5.8.81 400

MADE

HENDELD D.

HOLLAND

SHI NO 1 OF 4

C0261 05 M000

Y GI

CTB comments included

ALTERATIONS




4110 A/4/30/01 Cycle Gascompressor Greek Petrochemicals SA / Greece Our order LC 0261-63

Applicable specifications:

<u>Specification</u>	Description	Status
FWI Specifications		
a. 5860-1100/1	Welding requirements	no comments
b. 5860-1110/1	Unfired pressure vessels	comments given
c. 5860-1210/1	Shell and tube heat exchangers	no comments
d. 5860-1321 7 1	Centrifugal compressors	comments given
e. 5860-1370/1	Motors	subvendor comments
f. 5860-1393/1	Special purpose oil systems	pending comments given
g. 5860-1500/4	Special requirements com- pressor piping	no comments
h. 5860-1610/4	Local control panels	not applicable
i. 5860-1700/a	(tables a to f only)	no-comments
j. 5860-1700/b	Electrical material	no comments
k. 5860-1830/1	Painting	comments given
1. 5860-1900/1	Packaged systems	comments given
m. 5860-1930/1	Pressure testing	no comments
n. 5860-1960/2	Noise	comments given
o. 5860-1980/1	Preparation for shipment	comments given
FWI_Drawings		
a. 5860-93e3	Pressure vessel tolerances	no comments
b. 5860 4-73-1	Grounding of structures	no comments
CJB Specifications		
a. MS 73.132	Machinery guarding .	comments given
b. 4110/90/21/03 rev. B	Instrument specification	no comments
c. CJB supplement to FWI 5860-	-1110/1	comments given
d. 4110/phe/f1	Finishing reqts for heat exch.	not applicable
e. CJB supplement to FWI 5860-	-1210/1	no comments
f. CJB 4110	Piping specification	no comments
g. 4110/31.02/f	Vessel finishing and seling	no comments
h. 4110/550/ 1	LV motor data and approval	no comments
i. 17116 rev. 4/appendix A section A1/A2	sheets Inspection code classification	comments given
Applicable API specifications		
API 614, sept. 1973 edition	Shaft sealing and lube oil systems	comments given
API 617, 4th edition	Centrifugal compressors	comments given

MICRO <u>C0261.05 M000</u> Sh. 2 of 4

					100	II	8.00	1		1	15					1	T	10	E	T		T	T	PERFORMANCE TEST (OPEN BIR ACC.		SAIK	L
QUA	ALITY P	LAN		a transaction	QP			×	BUIGPROEF HARDNESS TEST	0	EXA	-			7					1	NDA	TEST	2	35	1	BUBBLE)	
FOR WELDED CA	SE COMPRE	ESSORS	SERIES	BANDC		1	TENSILE TEST AT ROOM TEMPERATURE TREKPROFF BU KAMERTEMPERATUUR	TOU	1.53	100	RAN	E .		TION	EALL	N I		1	ER		AGE	AGE	ZI	S. P.	RUN.	ME	
COMPRESSOREN	MET GELAS	T HUIS	TYPE B	+ C	THE CREE		RAT	ATU-			NE	ENE		E E	MAA	15SE		1	ANC	7	TEST	RUN	PAT	2	書艺	1	
DLS CLIENT C	1B Ltd for	HIMIC - Gre	2000		ENT SPEC.		M PE	E H		×	NON MA	90		ALIF	GHT	EST			VER		E E	FTER	DES	A-A	# HECH.	AIR (SCAP	
CLIENT ORDER NR 4	11c/A/4130/01.	Item: 4	10011001	FWL	5360-1321/1		Y TE	MER		10 N	RZO	, EN	N Z	IFIC F	E I	AL V			ATERLE	10	ST	SS A	PACE	1 -	াৰ	K	
	C0261,0262,	0263				S 18	ROOM	XA		INAT	AMI	X Z	1.06	WAL	ATH	SSU			OHO NIM	N	A 25	H H	BEF	TES	1	T.	
Texas *100				MANUELOGIC	T TECT . C	LYS	AX	F B	TS	X AM	CH C	AZOE ENT	N N	RE K	DIN	PRE		EST	EXA	E BU	ECT	BE	FRS FION	1111	SPARE ROTOR FIT IN	MIT.	1
	N	ATERIAL		MANUFACTU- PUNC AND/OR	FEST NG PROCED AND ACCEPTANCE STANDARD	ANA	F B	PRO	- 14 12 12	3 2 0 0	PAR	ATM	ELIE	FUU EEDU	GAR	OP TIC	9 %	ED HEN	HOLE	ROL	AL RI	AAI	PEC	AN	010	7	
COMPONENTS		IN ACCORD.		WELDING PROCEDURE	STANDARD	CAL	HE HOE	SLAG	NES:	A JUN	SGR A	TRE	SSR	PROC	H HS	OSTA	NCE H	SPE	CON	CON	NIC	FOR	INS	DRI	THE PERSON NAMED IN	Z E	1
GNDERDELEN	DESIGNATION		SPECIFIC.	BEWERKING	PROCEDURE+	E E	ENS	ERF	ARD	LIR	ADIC	CHEL	TRE	VEL (ASSE	YDR	ALA	VER	AAT	ISUA	ISU ECH/	ROE	INAL	ERF	PAR	LEAKTEST	
	AANDUIDING	VOLGENS	NKOOP SPECIFIC.	EN /OF LAS	ACCEPTATIE	00	3.18	2 1 2	119 3.1	0 2 10	2102	(A) I 3	23	7 2 3	2 7 0	U 215	3.18	210	2 2	1 B	> X	2 = :	= LL LL	10	10	-	Ļ
SARRESSON COMPL ASSEMBLED		North	Si Lon io.	VOOR SCHRIFT	NORMEN	1 2 3	3.18	318	19 3.1	3 3.10	3.16 3	.18 2.3	12.3			3.15	3.16	3.16						1	2		1
THE STEPRES OF THE STEPRES				API 617	API 617			,	\perp										_	1	SL P	L SI	L SL		PL 3	_	1
45. 10 (-44 HATTL) US	HIT + C22.8 HR. 1.0425+1.0460	01N Vertu		ASME IX	DIN 17155	V	٧		٧								-			17	李显		2 3				
TYER LEGA BOTH SIDES _ FORCING)	C22.8 NR. 1.0460	VATUV 350	CO26122P515 CO26122P502			Y	V	V												s s	s		3				1
			COMPLET SOL																		3 3	1 3	A IT				
						11-		+	\dashv			+	1			145	34		1	7	1 9		-	1			H
LATE EDGES BEFORE WELDING				A.7845 104	ASHE VIII-1	11-		-	+	t>25			+-		-	-	1	1.	-	-	s		-	+	+-		\vdash
ASKANTEN VAN PLAAT IVOOR LASSEN					UG 93(b-3)		-	-	-	٧		v			-	-			-	+	- 29	*	2 2	+			+
ASING FABRICATION UIS GELAST		agoja - c mas	C2261.12.P500	A.7845104	A.7835 105		14.00	578 B	9-7 × 2 × 1		1205	911 -981	A	YES	YES	no me	- History		S	er e	S.	80 709	E COS	Political Parties	177.72.7	F90-	
ASING WELDS AFTER STRESS REL. ASSEM AAN HUIS NA GLOEIEN	Light Magazini	4500	27.KM	2.64	第2年节节持		25 a.	189	Se pi	3 300	-	/s	1 13	847	26- 14		16	(G)	2 1	£K	s	E 183	A ST	1	\$17	特	
TUOS FOR MAIN JOINT	34 Cr. Ni Mo6 NR. 16582	DIN 17200 -		A 4102	A.7835 5:0	V	, y	V	0	plian	60				P					5 5	s	1	1.5				Γ
APEINDEN VOOR HUISDELING UTS FOR MAIN JOINT	24 Cr. Mo5	DIN		A 4102	A.7835 510	cer	vie c	V							F					s s	5	4 7		1			1
OEREN VOOR HUISDELING ASING MACHINED AND ASSEMBL	NR 1.7258	17240	-		API 617	Cer	Titic	ate !	of com	idia	nce.	_	+-		+	PL			-	-	s	2 3		-	+		+
UIS BEWERKT-GEMONTEERD	нп	DIN	CO261 28 W 500		PAR.72	-11	\vdash	-	_	-			+-	-	+	PL	-	\dashv	-+	+	50 200	2 4	-	+-	-	_	\vdash
NLET CONE NLAAT CONUS	NR.10425	17155			17155	ν	٧		٧				1							S S	S		\perp				
IAPHRAGM AFRAGMA	NR.1.0425	DIN 1 17155	C0261 29 W500		1 0IN 1 47 155	V	V													s !	S	1	4 - 3				
HAFT (RAW MAT'L)	42 Cr. Mo 4 NR.1.7225	SEW 550-76	LS 088		A.7835. 913	V	v	v	V	v		V	V							s s	s	4 -		T			Γ
S - SMEEDSTUK HAFT MACHINED	NR, 1.7225	330-40			ac 2014	1	\Box	1			-	Р	1		\dashv					s :	s	-					1
S-BEWERKT MPELLERS (RAW MAT'L)	20 Ni Cr Mo12 7 5		LS 172		DE 15-344	V	v	-		v		V	+		\dashv	-	+		-+-	+				+	+-		+
MARIER-MATERIAAL MPELLERS FABRICATED AND MACH.	HY 100	TYPE B	1 (3 1/2	A 7845 102	1	łř	+ 1	\dashv		+	-	- 1	+-		+	+				11	S	-	-	+-	-		\vdash
AAIER-GELAST-BEWERKT					A7835104	11_	1			1		p ¹⁾	Р	YES	ES	_	P	PL	P	L	S	1	-	\perp			L
OLE PLAAT /OET PLAAT	U5t. 37.2	17100										_								5 !	S	片牌	1				L
OTOR ASSEMBLED OTOR-COMPLEET		17.11			A 63 51.20							-	-			2	PL		1	,	s	羅薩	日景				
EALS	ALL Alloy	ASTM 826-74	-					10						- 1-			ja.			5	s		63	1-12	1		Γ
FDICHTINGEN E ARINGS		Alloy 713-0	 			1			1			-	\top			\top			1	s s	s	En ju	-				1
AGERS BEARING SUPPORT	υπ	DIN	Co261.22 PS6			1			+			-	+			+			+	-			- 10	1	-		-
AGER ONDERSTEUNING	NR. 10425	17155				-	-	+	-	+		+	+			+	-			5 5	255 SE	8 15	- 53-	1	-		1
BEARINGHOUSE AGER HUIS	65-C25		Co261.320500 L8406		1.000	1			9, 1				1		1 1		1		15	5 5	5	S Is	1	· Py			L
MAIN ELECTRIC MOTOR : BY	17.3.		1075		100 mm	N	0 51	RING	TEST							1	-	-		+ 3			i		1		1
EMARKS OPMERKINGEN				TROL DEPT/NO C					E TO DIN							PT.	DRAV		atio	5	-8-81	STA					
DI BEFORE AND AFTER OVERSPEED TEST INSPECTIE DOOR DLS KWALLTEITSDIENSTIGEN CERTIFICAAT DI NSPECTIE DOOR DLS KWALLTEITSDIENSTIGEN CERTIFICAAT DI INSPECTION BY INDEPENDENT AUTORITY CERTIFICATE TO SIN SOCIATION TERTIFICAAT ANN KLANTTE JENDEN DI INSPECTION BY INDEPENDENT AUTORITY CERTIFICATE TO SIN SOCIATION INSPECTION BY INDEPENDENT AUTORITY CERTIFICATE INSPECTION BY INDE												9-318					ISSU	-		-	(1-7 g/%)				TY		
												9-23 0				R-LE	-		2.6	15,482	3943	78	<u>C0</u>	126	1.05.	MO	00
	L.				1	11 3				100												1 cur	EET	2	OF	4	200

 

,	QUA	LITY P		STEM	-972	QP	IRE	E 6	to welding	Welding for Lamilat		PENETR	AT 10N	AT CN	326 : INC		SYSTELM	B.SUPPLIER CIER		ERK)	6.1	LCH J	, k	ICATE		IEC IP CODE
	CLIENT ORDER NR. 4/11/ CELALA STER . DLS PROJECT NR C8 PORCES DE OPDER NR LC	1. B Ltd for 0/A/4/30/01 0122 0261,0262,0	. Iter	Greece m: 430/13	CLII	ENT SPEC. 5860-1393/1	T.A. HOOM TEMPET	ANEHTEMPERA JUH	de print to	edges for v	A MINATION DMDEHZDEK	EN MAGN OF PEN	OLDEIEN DURE QUALIFICATION	MARKE GIAL FIL	CLAAL JE HW	1 - ,	LEAN TEST T WATER	AMINATION AT SU	AMIN AT DES	ON LINCL WELD	TESTAGENDA !	HEFORE DESPA	DATA BOOK BEPROEVINGS BOEK	CLASSIFICATION CERTIFICATE	N TEST	70
	COMPONENTS ONDERDELEN			FL - C NAS SPECIFIC INKOOP SPECIFIC	AND/CR AN	ACCEPTATIE	CHEMIEN AND CHEMININE AND	INERPRICE BY K	main sams that	inspect plate	ULTRAGELUIS SUNDERZUEN RADIOGRAPHIS ENAMINATION RADIOGRAPHISM ONDERZOEK	SCHEUR ONDERZO HEAT THE ATMEN	SPANNINGSARM WELLING PROFE	WELGIES PROFE	CON ALL E DE MAIS NYDRO 14 FL. PRE	CLEAN DIESS VIS	HYDROSTATIC LE	DIMENSIONAL EX	DIMENSIONAL EX	VISUAL INSPECTION (PICL. WELCS) VISUELE INSPECTIE (INC. LASWERK) UPF. A. CHALL FEST (SEE TESTAGENDA)	HEPROEVING 1 Z	FINAL INSPECTION BEFORE DESPATCH FINAL INSPECTION BEFORE DESPATCH EINDCONTROLE VOUR AFLEVERING	MANUFACTUHES D	REA	CALIBRATION TEST	CONFORMANCE
	LLET SPAL CONTRICTOR SYSTEM ASSEMBLED ONE RECORDING RESELECT SAMENGES.				DUD-TECHNICAL SPECIFICATION	NORMEN 5860 - 1393 /4		-							+	s			S		1 -	S			1 (3	
	COMESTRYOR CONTANA	carbon steel				2860 - 1393 /1										s	S	-	S	S	14			5 .	145	
A	EF MAEN COMPLETE (Allweier)					*-									V		77.12				V	i F	b	W V	1.15	74-
	CASING/ SPINDLE MAT. HUIS/ SPINDEL MAT. OIL COOLER COMPLETE OLIEKOELER COMPLET (FUNKE) TU BES/TUBESH./ SHELL MAT.	admInaval scarbon ste	bross/		ASME IX	TEMA "C" 5860-1210/1+5up	7	-	/		U		1	٧	v	SL S	200	5	- 1	s			y			
(A)	PÜPEN/PIJPPLAAT/ ROMP MAT.	acarbon st	eel.				V	'	٧L		V				-	+						14				
A	DUBBEL OLIEFILTER COMPLEET (Arlon) CASING MAT. HUIS MAT.	carbon steel		17 1 1 1 1 1 1 1 1 1 1 1 1 1 1 1 1 1 1	ASME IX	ASME WILL	Pv P	v	VL	0 -		31 (3)	¥	TEI	- V	SL S	2 65.54	5	100	5	- 2 - 24	100	V	(F) (C) (E) (E)	2 3 5 °	est of
		CAT BON SIZE										250	200				S ARES	32.00	35		2 2	14				
	ELECTRIC MOTOR FOR DIL PUMP ELEKTROMUTUR VOOR OLI EPOMP (Newman					5860/1370/1				Cycle 1					1				\$	\$	5 5			VE		-1 =
احمد	O PIPING COMPLETE OLICLEIDINGEN COMPLET PIPE AND FITTINGS OCWNSTREAM FILTER PUPENEN SLITINGS ACHTER HET FILTER	carbon steel		1 1 1 1 1		4	V .	v			5 pots		Р	P	P	L S	-	ry.	3	5						=
A	COLLECTING TANK. VERZAMEL TANK	January seed	5 0	[ASME IX	ASME VIII			MAN COLO	1 20 12	עע		Р	Р	V	54	1	5		5	- 5		v	100		\dashv
	TANK HATERIAL TANK MATERIAAL						V	v	٧L	٧L						7					1	- 54	- 1	e- 13		, h.
3	SEALOIL OVERHEAD TANK COMPL. DICHTINGSOLIE BOVENTANK COMPL TANK MATERIAL	carbon Steel	90		ASHE IX	ASME VIII		v	1		V		Р	P	V	51 5	- 1	5		S	e ilizio		٧,			
	TANK MATERIAAL DEMISTER DRUPPEL VANGER	carbon steel	3					+	VL	VL			P	P	P	LS	-		5	S		100		- 12	4 - 52	7
A	DEG ASSING TANK	Carbon Steel	€	PATT - 7	ASME TX	ASME VIII	V	y	VL	V/_	VV		P	P	V:	-	s	5		s	2 12	1	V			
12.	GAUGE BOARD		1. [2004] 四点整数		1. 1. 1.	为对此中《报》					2.5		(1: p)		4 13	1 1/4		1931 S	5	S						
(9)-	DOUBLE STAGED THREE-WAY VALVE DUBBELE DRIEWEGKLEP ELECTRICAL EQUIPMENT . (SWITCHES, HEATERS ETC.)	NOT APPLIC	310-3111	NGLE CO	OLEIZ	4110/90/21/03							Р	p	v	30 30 40 41	- I		S	S			V	E	V2	V
313 113	JNSTRUMENTS	3-400	Elsik.	77/21/32/20	par in the	4110/90/21/03	100	-					2	11		1							V	-	P.	V
A	PRIMARKS OPMERKINGEN PRESSURE VESSEL INSPECTION PER CIG issued list. THE PART TO BE SENT TO CUSTOMER FROM THE ANY KLAMITE ZENDEN	D INSPE	ECTION BY NO	S KWAL TEHTS	TROL DEPT / NO CE DIENSTYCEEN CERTIFICA UTORITY CERTIFICA E KE IR NUS NSCA	ERTIFICATE HEIGAAT	V CER	P CERTIFICATE TO DIN SOULS-318 BY DLS DUALITY CONTROL DEPT CERTIFICAAT VOLGENS DIN 50919-318 BOOR KWO-015. 
	1) Pending on code requirements 2) For heater setting of thermostate	BI/MO	NEN INSPECTIE	DOOR FLANT	S REPRESENTATION ZUN VERTEGEN	IWCORDIGER	ECe	ertifi as bi	een d	esigne code	urance d and or sta	. certi manu ndard	rying factur	that ed in	elect acc	trica . wit	th B	he	nent	766				OF 4		H
[3]	53 310n an incidental basis, when i	ndicators sh	nows at ru	nning test	, not to ope	rate properly					-14							Se . 3						-1		