


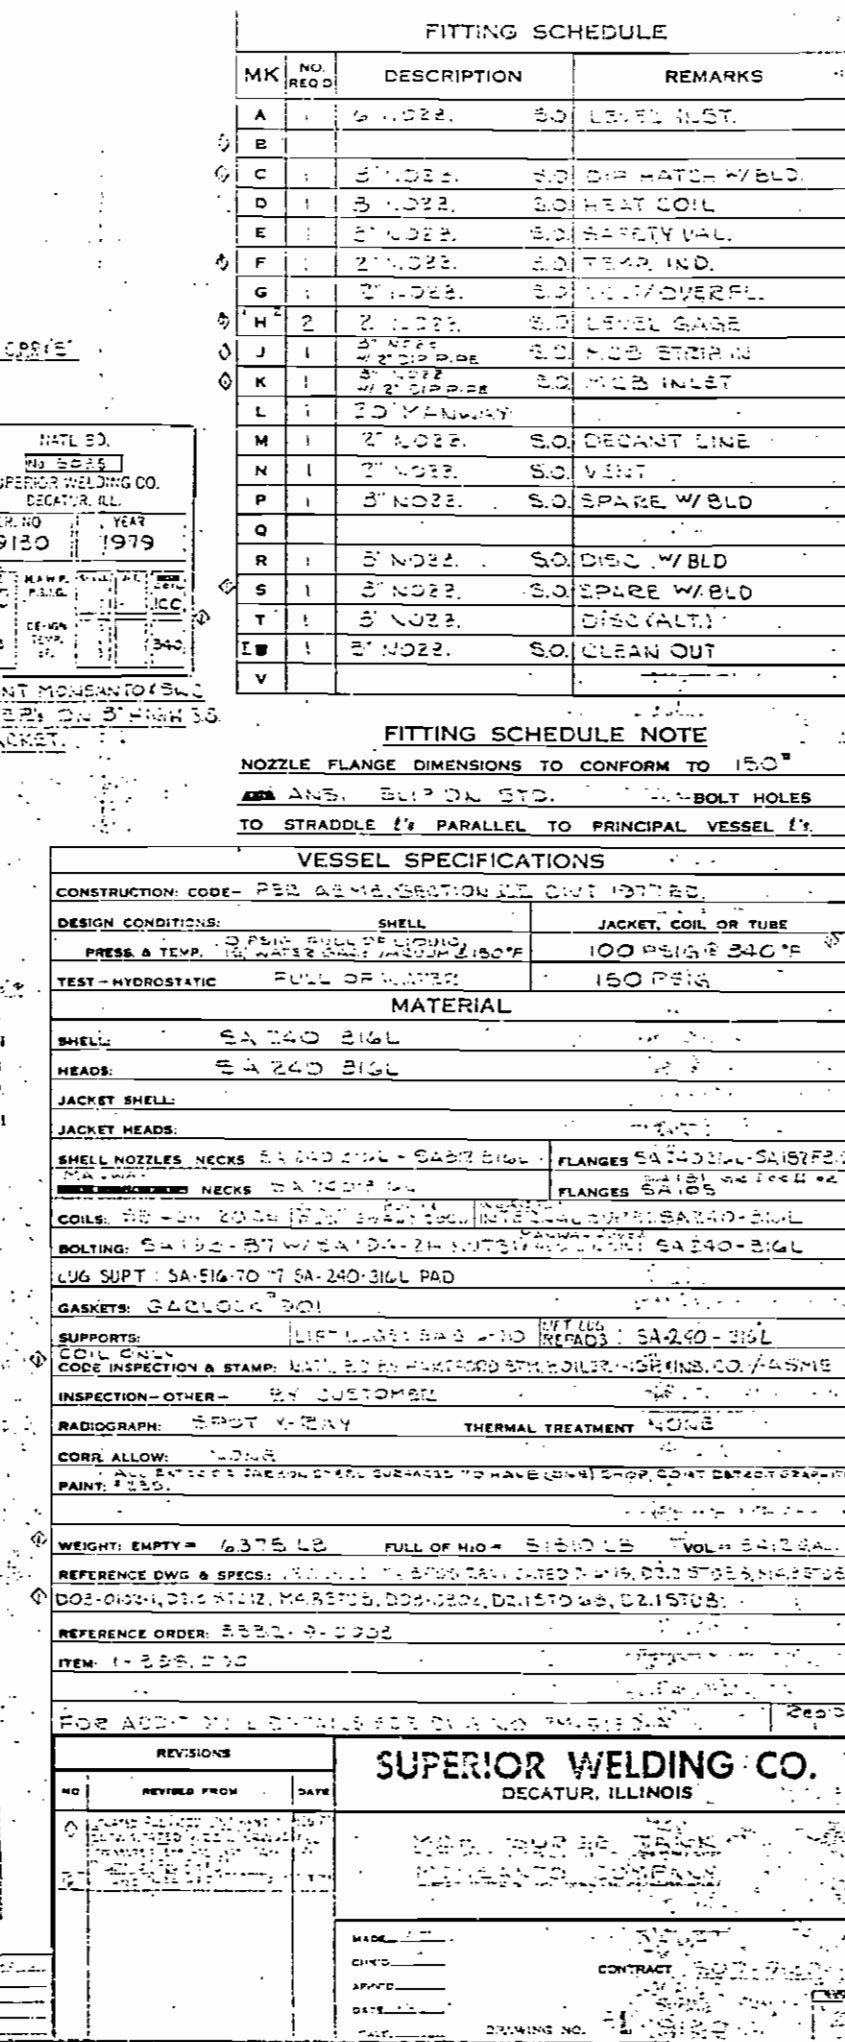

8621