


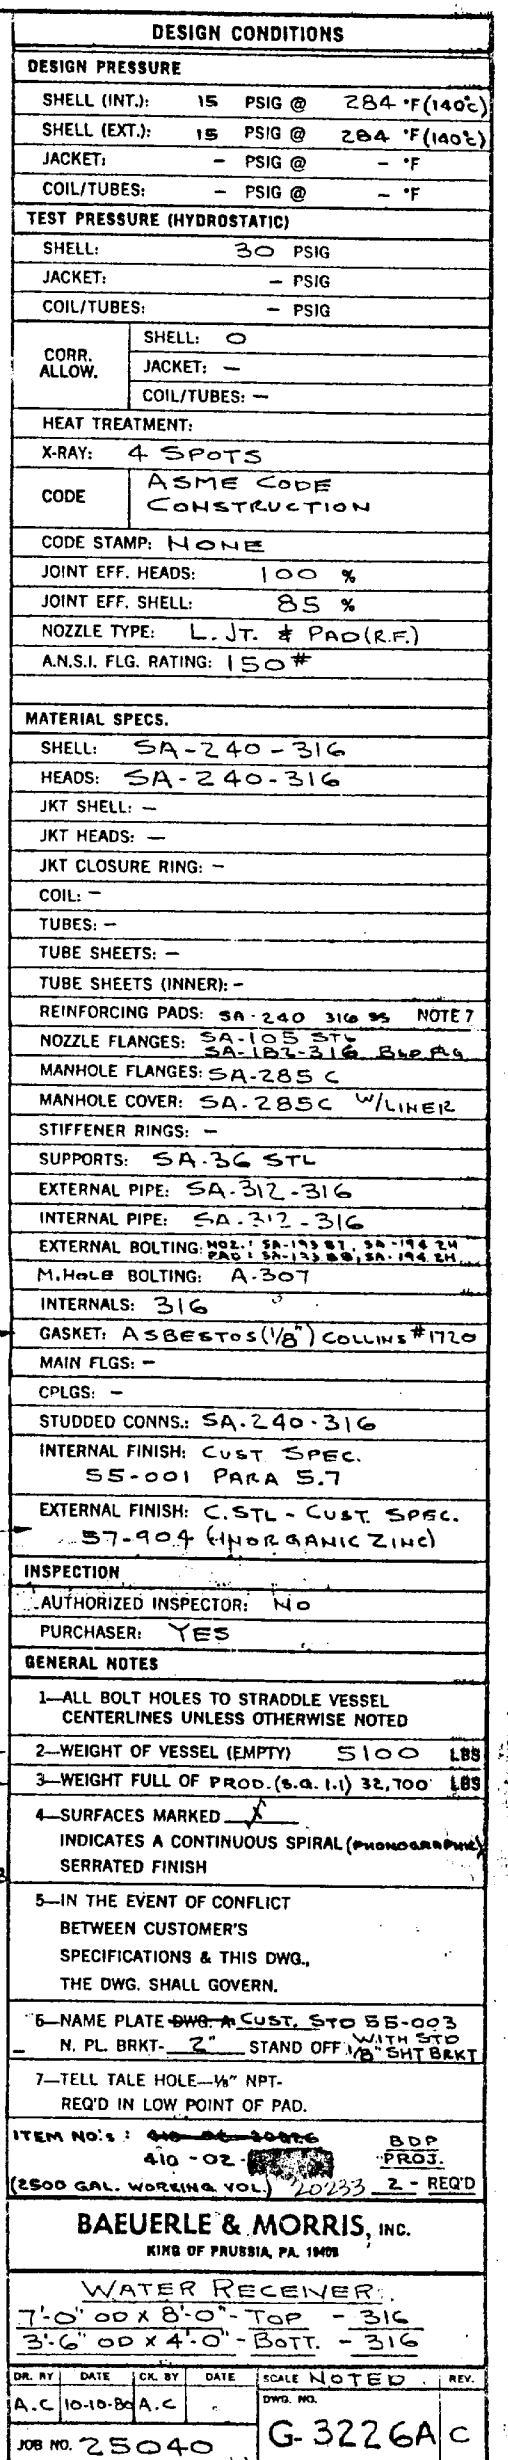

(2)	C	SUPPORT LUGS WERE 2'-0" BELOW TOP T.L.	D.W. 11-28-B
	B	CHG'D ELEM. OF UPPER GARDEN. ADDED REINF. TO CHG'D BARS ADDED REINF. PAD TO 80T. HD. CHG'D ELEM. OF NO. 2'S 11-19-B	D.W. 11-28-B
	A	RELOCATED NO. 2'S 11-19-B CHG'D. PER CUST. MARKED PRINT.	D.W. 11-18-B
MARK		REVISIONS	DATE
		THIS DRAWING IS THE PROPERTY OF BAEUERLE & MORRIS, INC. AND IS LOANED SUBJECT TO RETURN ON DEMAND AND WITH THE EXPRESS CONDITION THAT IT IS NOT TO BE USED DIRECTLY OR INDIRECTLY IN ANY WAY DETRIMENTAL TO OUR INTERESTS.	

88295