


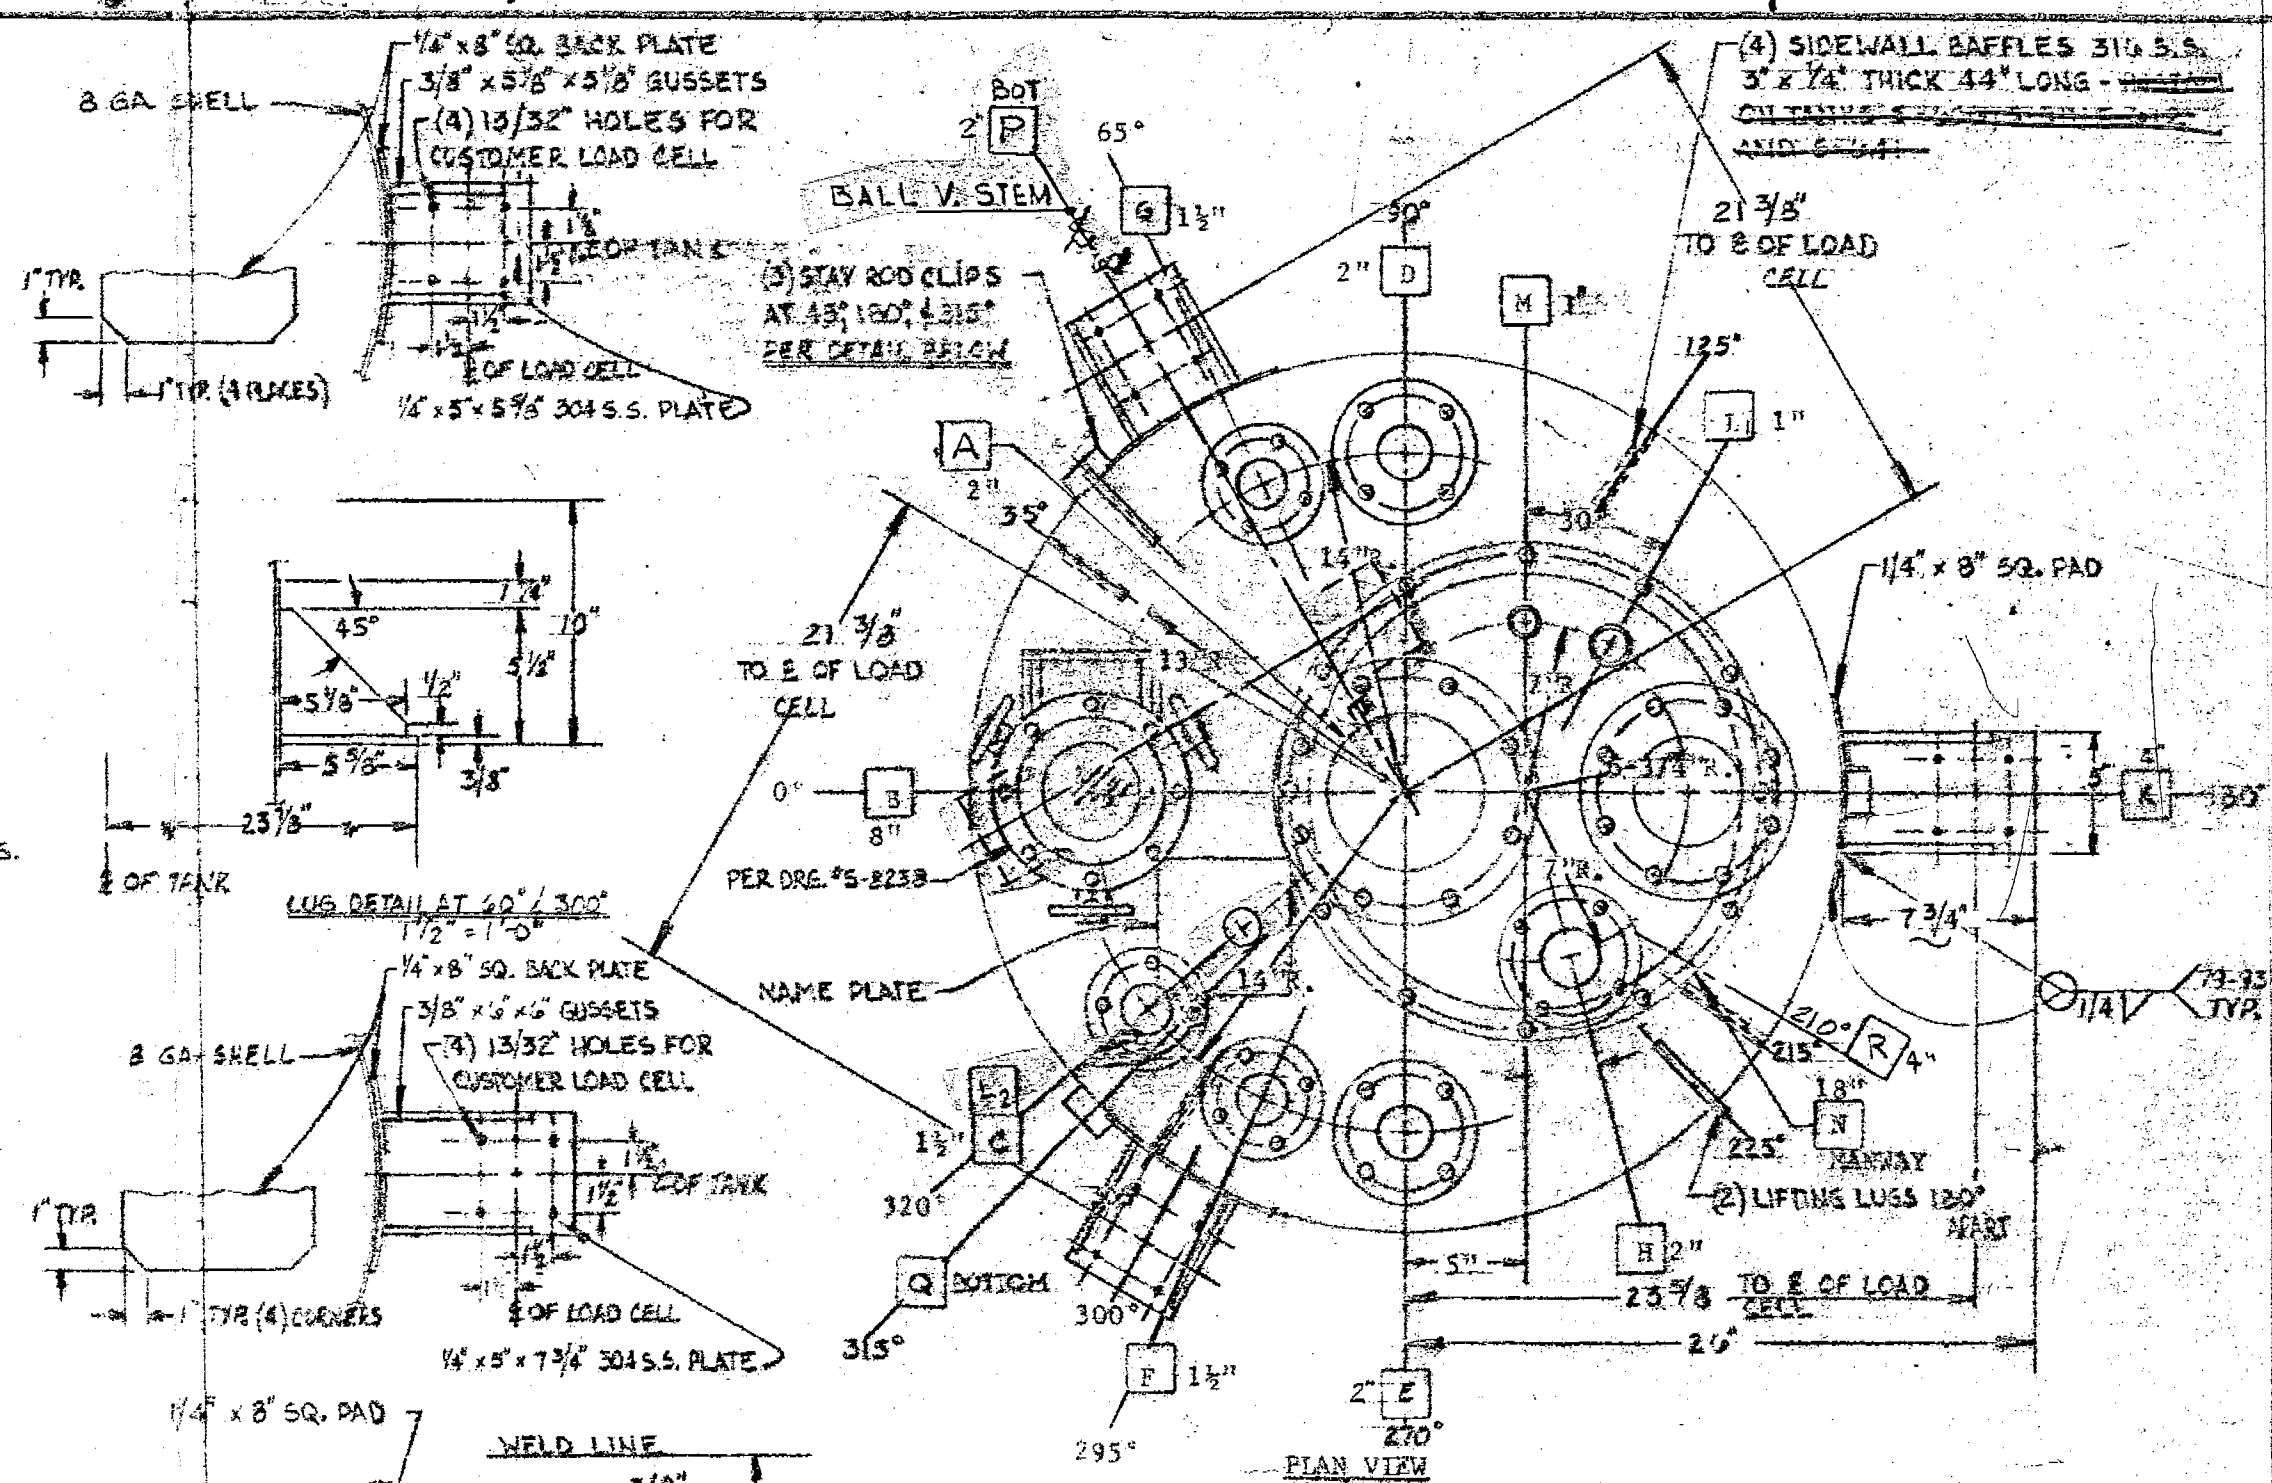

WARRANTY:

Walker Stainless Equipment Co. warrants new tanks or equipment manufactured by us to be free from defects in material and workmanship under normal use and service for a period of 1 year after shipment from the factory.

For breach of warranty of any kind, the measure of damages to be recoverable from Walker Stainless Equipment Co. shall be limited to repair or replacement of the part or equipment which examination discloses to the satisfaction of seller to be defective, or the payment of the price or making such repair or replacement, at the option of the seller.

This warranty is expressly in lieu of all other warranties, expressed or implied, and all other obligations and liabilities on our part. Any warranty of merchantability is expressly excluded. We neither assume nor authorize any other persons to assume for us any liability in connection with the sale of our products, and no other warranty will be honored unless in writing and signed by an officer of the corporation. This warranty shall not apply to any product of our manufacture which has been repaired or altered outside our factory, or which in our opinion, has been subject to misuse, negligence or accident. Seller will not be responsible for any claim or responsibility for time due to repair by manufacturers beyond the time of said breach.

Any action for breach of warranty must be brought within one year of said breach.

All information in this document is confidential and others, or used in this document by Walker Stainless.


POLAROID CORPORATION
 GENERAL ENGINEERING DIVISION
 CAMBRIDGE, MASS. 02139
 

D-655A-NB-B
 D-655B-NB-B

AREA NO
 521969

BLDG NO.

ISSUE/REV



ALFRED W. CATALDO

WALKER STAINLESS EQUIPMENT CO., INC.
 NEW LISBON, WISCONSIN 53950

SCALE: 1 1/2" = 1' - 0"	APPROVED BY	DRAWN BY G.S.	
DATE: 2/20/79		REVISED 4-23-82	

200 GALLON TANK - FREETOWN PLANT -
 D-655A-NB-B & D-655B-NB-B

DRAWING NUMBER
 SP-8156 NB

POLAROID CORP., LEXINGTON, MASS.

DRAWING NUMBER
 SP-8156 NB

NOTE — DO NOT SCALE THIS DRAWING!