

- ## BILL OF MATERIAL

MISC. MAT'L'S

GASKETS	ASBESTOS
---------	----------

NOZZLE SCHEDULE	
-----------------	--

THESE DRAWINGS HAVE BEEN REVIEWED FOR
DESIGN ONLY. ACTUAL SITE AND PROJECT
DIMENSIONS REMAIN THE RESPONSIBILITY
OF THE GENERAL CONTRACTOR.

THE FOLLOWING ACTION HAS BEEN TAKEN:

- ☒ APPROVED AS SUBMITTED
☐ APPROVED WITH CORRECTIONS
AS INDICATED
☐ NOT APPROVED - RESUBMIT

DATE: Sept 13, 1984 BY: RLH

FMC Agricultural Chemical Division
Baltimore

MIDCO DESIGN DATA DESIGN BY _____ DATE _____
CHECKED BY _____ DATE _____
WELDING BY _____ DATE _____
APP'D. FOR FAB _____ DATE _____


CUSTOMER P. O. NO. _____
PIECE NO _____
PART NO. _____
ESTIMATED WEIGHT _____

93732

V-630


MIDLAND STEEL CORP.
COLUMBIA, S. C.
29201

1940 SHOP ROAD		COLORADO S.L. 79201	
SCALE 3/4" = 1' - 0" UN	APPROVED BY	DRAWN BY T.B.	
DATE 8-16-39		REVISED	
WORK FOR EM C CORP 34 Annex			
ITEM V-630 EMULSION HOLD TANK	OR NO	DRAWING NUMBER 4812	

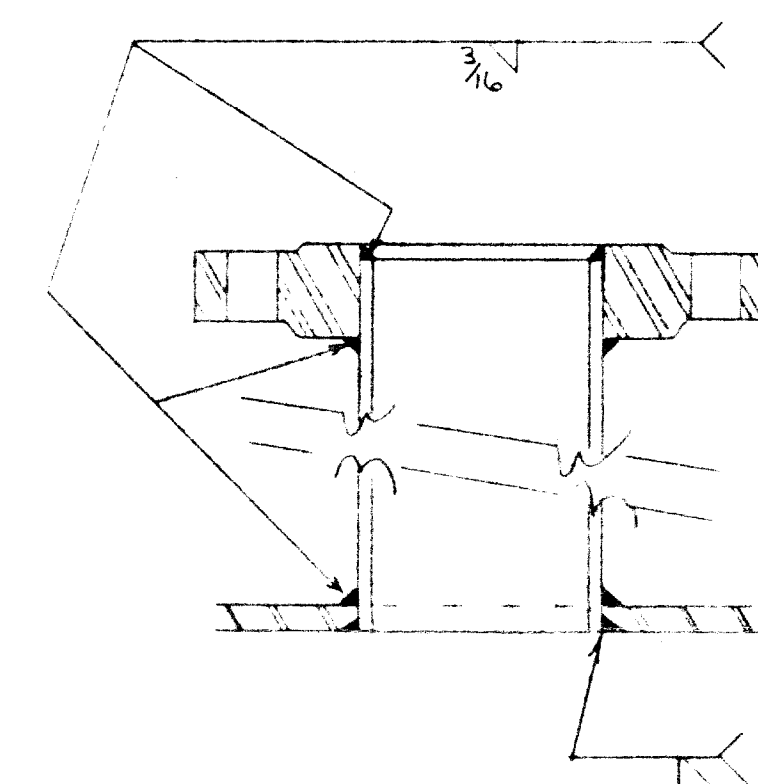


TYP. NOZZLE WELD DETAIL

SCALE NONE

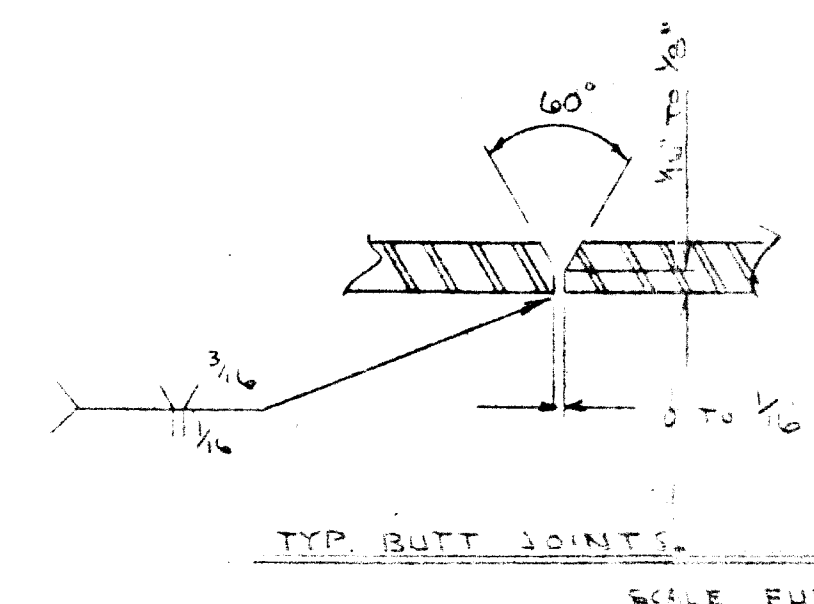


TYP. BUTT JOINTS.

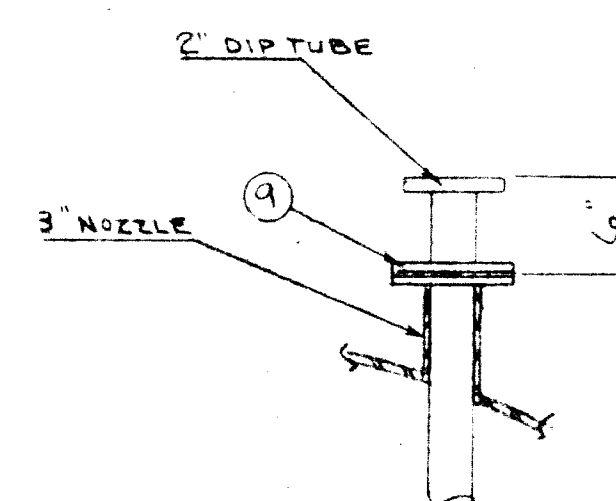

DETAIL B DIPTUBE

SCALE 1"=1'-0"

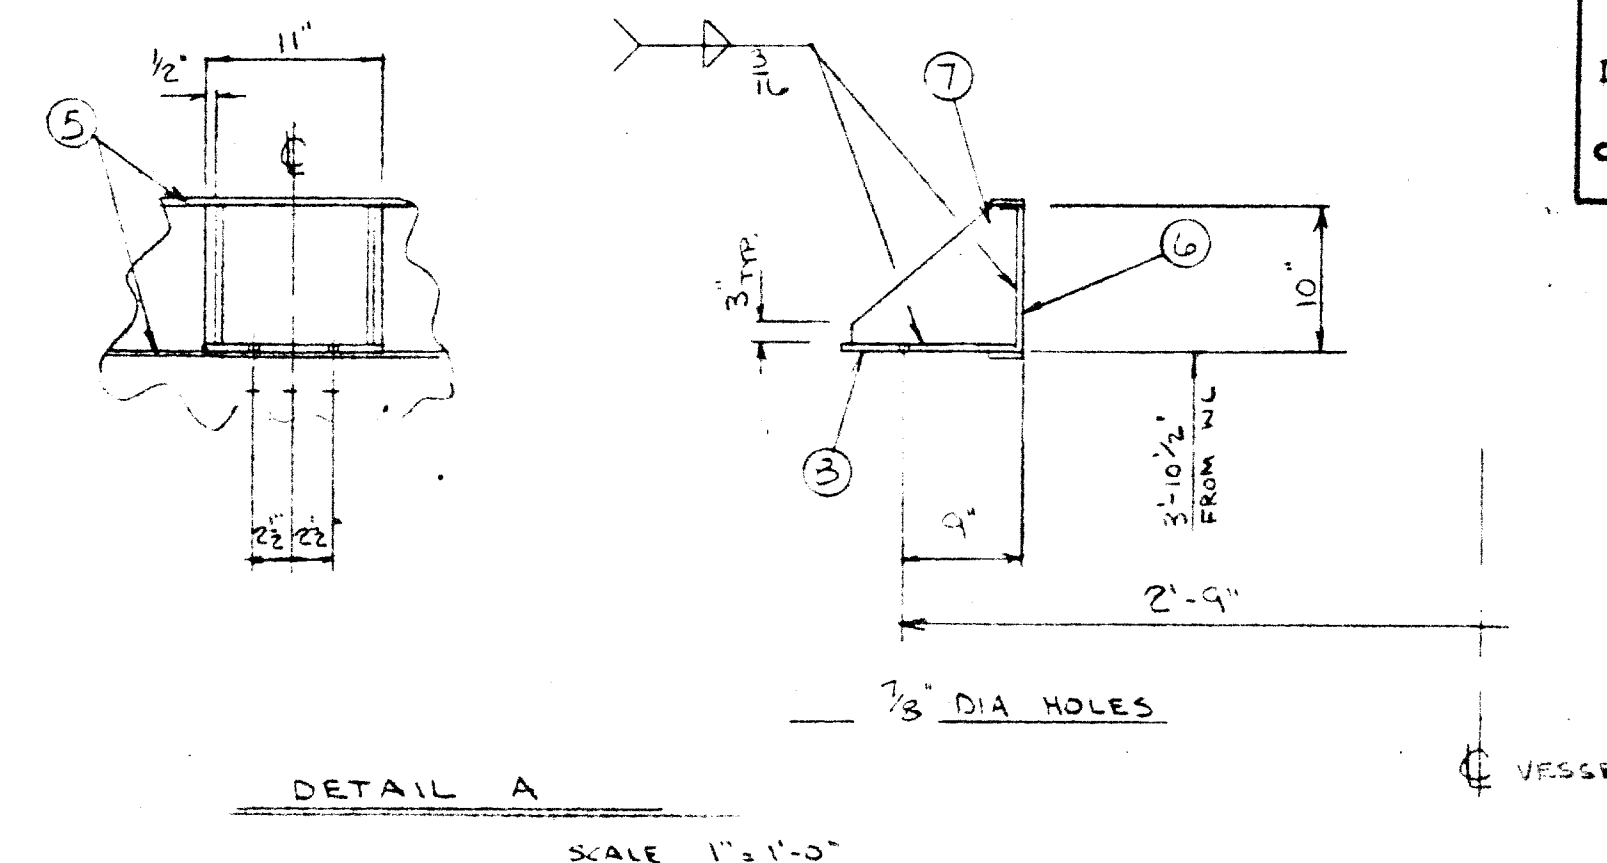

DETAIL A

SCALE 1" = 1'-0"