


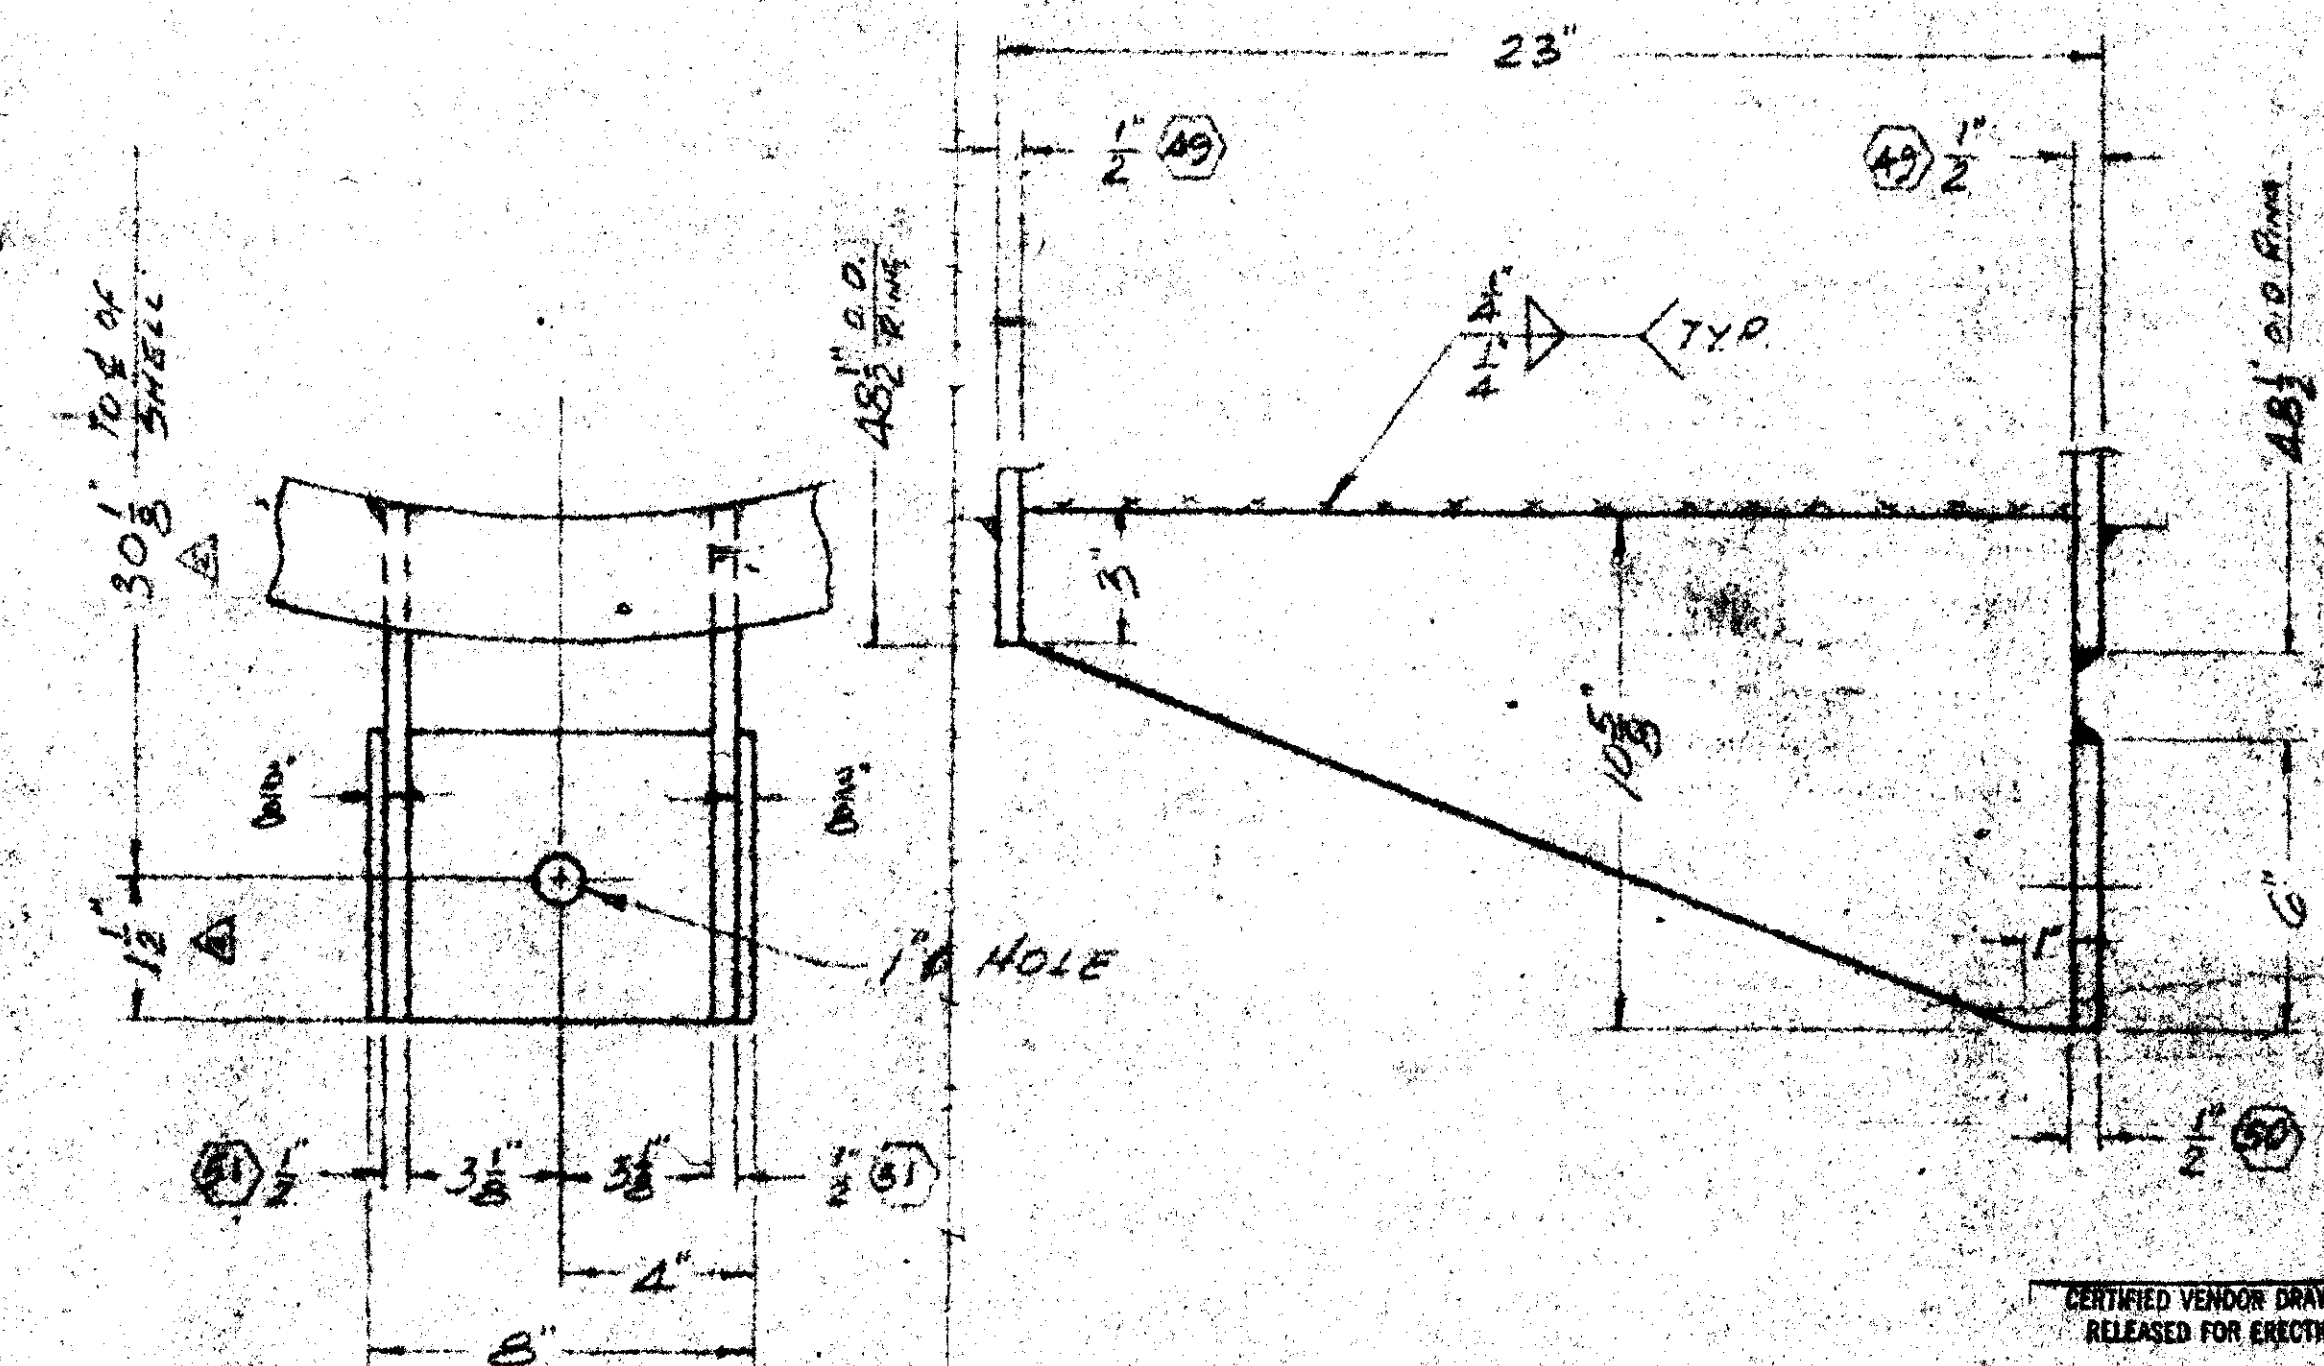

CERTIFIED VENDOR DRAWING
RELEASED FOR ERECTION
MAY 08 1979
D. I. No. 11-627 BY *2*
FOSTER WHEELER ENERGY CORP.
LIVINGSTON, N. J. 07038

FULLY APPROVED FOR FABRICATION
 APPROVED FOR FABRICATION, SUBJECT TO
 THE NOTED REVISIONS AND/OR COMMENTS.
 This drawing approved as to layout and general
 design. No responsibility is assumed for
 detailed design, dimensions, or construction
 of equipment. This approval does not warrant
 supplier or contractor from any liability in
 construction herewith.
 POSTER WHEELER ENERGY CORP., WINSTON, S.C.
 DATE 6/27/82 BY J. J. J.

ITEM #88-T-301
EQUIP CODE #SEP-302
F.W. CONTRACT 15-2192
F.W. REG# 2192-12112
F.W. P.O.# DP-224-115-2192
HOFFMANN LA ROCHE INC.
BEVERLYDE, N. J.
VITAMIN C EXPANSION

DETAIL "H"
TYP ALL VAN-STONE NOZZLES

CERTIFIED PRINT
SUCCESS ENG. & MACH. CO., INC.
DATE **MAR 9 1975**

3	REV F W REG N NA	10/29	AP
2	3/4" DIA WAS 25% 1/4" DIA WAS 3	10/20	AP
1	REBAR BARS MATERIAL	10/18	AP
REV	DESCRIPTION	DATE	BY

PROCESS ENGINEERING & MACHINE CO. INC.
ELIZABETH  NEW JERSEY

[illegible]


[illegible]

99728